


LABOR AND MATERIALS

_____ Copper } Connection _____ \$
 _____ Lead }
 _____ Curb } Cock } _____ in. \$
 _____ Valve } T.S. & V. }
 _____ Service box { Short 3-1/2 x 4-1/2 } _____ \$
 _____ Old returned { Long 4-1/2 x 5-1/2 }
 _____ Ft. _____ in. { Copper } Pipe at _____ \$
 _____ { G.I. }
 _____ { C.I. }
 _____ Nipples _____ in. at _____ \$
 _____ Bushings _____ to _____ in. at _____ \$
 _____ Red'g
 _____ Inc'g
 _____ Union _____ in. at _____ \$
 _____ Meter _____ in. at _____ \$
 _____ \$
 _____ Compound Joints at _____ \$
 _____ Maintenance Foreman _____ \$
 _____ Hrs. Water Maint. Man - 1 at _____ \$
 _____ Hrs. Water Maint. Man - 2 at _____ \$
 _____ Hrs. Garage Foreman _____ at _____ \$
 _____ Hrs. Labor _____ at _____ \$
 _____ Hrs. Compressor at _____ \$
 _____ \$
 _____ Trucking _____ \$
 _____ Pav't Patch _____ \$
 _____ \$
 _____ \$
 _____ \$
 _____ \$

Prospect _____
 Name of Owner _____
 St. _____
 Pl. _____
 Ave. No. 65

11/24/10

Labor and Mat'l. Report 19

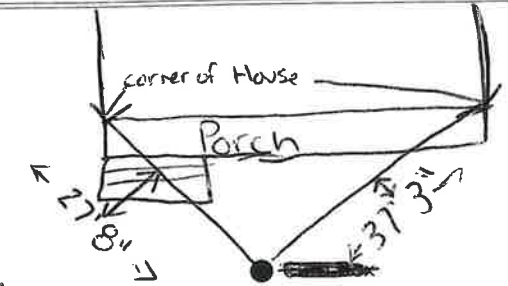

6" outside clean out

_____ Main _____ Elev. of Main at tap _____

Gate at ● _____ ● Gate at _____

TAX ID# 303.17-6-9

● Curb Box


Labor and Materials

Copper } Connection.....	\$
Lead }	\$
Curb { Cock	}
Valve	
T. S. & V. }	\$
Service Box { Short 3 1/2 x 4 1/2	}
Old returned { Long 4 1/2 x 5 1/2	
Buff. or Rdway }	\$
28' 3/4 in. { Copper	} Pipe at.....
Galv. Iron	
Cast Iron }	\$
Nipples..... in. at.....	\$
Bushings..... to..... in. at.....	\$
Red'g } Couplings..... to..... in. at.....	\$
Inc'g }	\$
Union..... in. at.....	\$
Meter..... in. at.....	\$
Lbs. Br. Stone at.....	\$
Lbs. Sand at.....	\$
Bags Cement at.....	\$
Paving Brick { Mack	} at.....
Red	
Asphalt }	\$
Lead Joints at.....	\$
Leadite Joints at.....	\$
Hrs. Foreman at.....	\$
Hrs. Common Labor at.....	\$
Hrs. Common Labor at.....	\$
Hrs. Mason at.....	\$
Hrs. Mason's Helper at.....	\$
Hrs. Compressor at.....	\$
Compensation Ins.....	\$
Trucking	\$
Builders' Use of Water.....	\$
Total \$.....	

65-
Labor and Material Report

July 12 1926

no. 55 Broadway St

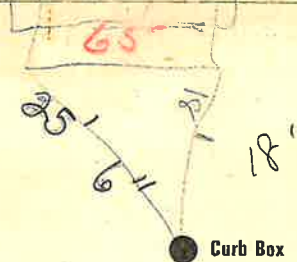

Main

Elev. of
Main at tap.

Gate at ●

● Gate at

● Curb Box

3/4" COPPER
28' to MAIN


Labor and Materials

1	Lead Connection	\$
1	Curb Cock	\$
1	Service Box (Short 3" x 4")	\$
1	Old returned (Buffalo)	\$
2.8	Ft. 3/4 in. G. Pipe at	\$
	Nipples in. at	\$
1	Bushings 1" to in. at	\$
	Red'g Coup to in. at	\$
	Inc'g Coup to in. at	\$
	Union in. at	\$
	Meter in. at	\$
	Cu. Yds. Br. Stone at	\$
	Cu. Yds. Sand at	\$
	Bags Cement at	\$
	Paving Brick { Mack Red Asphalt } at	\$
2	Hrs. Foreman at	\$
1.8	Hrs. Common Labor at	\$
	Hrs. Mason at	\$
	Hrs. at	\$
	Hrs. at	\$
2	Builders' Use of Water	\$
	Truck 100	\$
	at	\$
	at	\$
	at	\$
	at	\$
	Total	\$ 18.65

Labor and Material Report

30 June 1924

51 Prospect St.

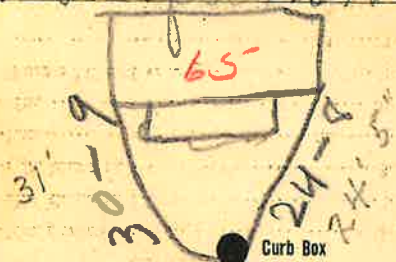

Main

Elev. of Main at tap 42

Gate at ●

● Gate at

● Curb Box