


Labor and Materials

Copper } Connection.....	?	\$ 1.48
Lead }	?	
Curb { Cock Valve }	in ?	\$ 1.79
Service Box { Short 3 1/2 x 4 1/2 }		\$ 1.46
Old returned { Long 4 1/2 x 5 1/2 }		
11 Ft. 3/4 in. { Copper Galv. Iron } Pipe at	3/4	\$ 1.98
Cast Iron }		
Nipples	in. at	\$ 10
Bushings	1/2 to 3/4 in. at	
Red'g } Couplings.....to.....in.at.....		
Inc'g }		
Union.....in. at		\$
Meter.....in. at		\$
Lbs. Br. Stone at		\$
Lbs. Sand at		\$
Bags Cement at		\$
Paving Brick { Mack Red Asphalt } at		\$
Lead Joints at		\$
Leadite Joints at		\$
7 Hrs. Foreman at		\$ 1.75
8 Hrs. Common Labor at		\$ 3.60
Hrs. Common Labor at		\$
Hrs. Mason at		\$
Hrs. Masons Helper at		\$
Hrs. Compressor at		\$
Compensation Ins		\$ 1.50
Trucking		\$ 1.00
Builders Use of Water Patch		\$ 6.00
Total		\$ 17.81

537-131 24
 Labor and Material Report Nov 3 1922

22 Prospect St

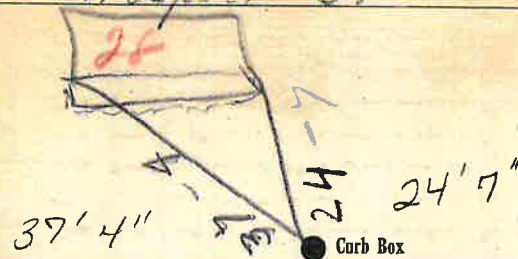

Main Elev. of Main at tap 5' Gate at Gate at

● Curb Box
 TAX ID # 303.17-14-1
 old taps shut off at
 Main

3/4" copper
 11" to main

[Signature]