

LABOR AND MATERIALS

1	Copper Lead	Connection	3/4"	\$	3.08
1	Curb	Cock Valve T.S. & V.	3/4 in.	\$	3.89
	Service box	Short 3 1/2 x 4 1/2		\$	4.32
	Old returned	Long 4 1/2 x 5 1/2		\$	
		Buff or Rdway		\$	
13	Ft. 3/4 in.	Copper G.I. Pipe at	45	\$	5.85
	Nipples	in. at		\$	
	Bushings	to in. at		\$	
	Red'g Inc'g	Coupl'gs. to in. at		\$	
	Union	in. at		\$	
	Meter	in. at		\$	
	Lead Joints at			\$	
	Compound Joints at			\$	
	Maintenance Foreman			\$	
	Hrs. Water Maint. Man-1 at			\$	40.00
	Hrs. Water Maint. Man-2 at			\$	
12	Hrs. Garage Foreman	at 20.33		\$	24.40
12	Hrs. Labor	at 1.30		\$	15.60
	Hrs. Compressor at			\$	
	Compensation Ins. at	\$ 5.686 per C		\$	2.27
	Trucking			\$	1.50
	Pay't Patch			\$	4.05
	Tap by Haregu + Wadleigh	6-21-56		\$	
	O'head			\$	
				\$	64.96


Prospect

St. Pl. Ave. No. 66

Name of Owner

Campinelli

Labor and Mat'l. Report June 20 19 56

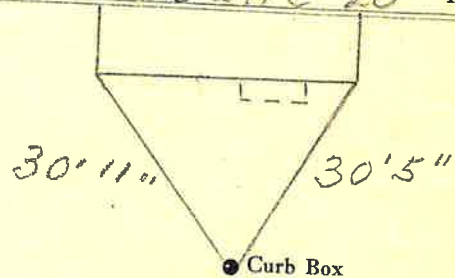

4" Main

Elev. of Main at tap 4'

Gate at

Gate at

TAX ID # 303.17-5-9

Curb Box

3/4" Copper
13' to MAIN