


**Labor and Materials**

1	Copper } Connection.....	3	\$ 2.60
	Lead }.....	4	
1	Curb } Cock Valve }..... in.....		\$ 2.30
			T. S. & V.
1	Service Box } Short 3/4x1/2 }.....		\$ 1.40
	Old returned } Long 1/2x3/4 }.....		
			Buff. or Rdway
6	Ft..... in. } Copper } Galv. Iron } Pipe at.....		\$ 1.59
			Cast Iron
	Nipples..... in. at.....		\$
	Bushings..... to..... in. at.....		\$
	Red'g } Couplings..... to..... in. at.....		\$
	Inc'g }.....		
	Union..... in. at.....		\$
	Meter..... in. at.....		\$
	Lbs. Br. Stone at.....		\$
	Lbs. Sand at.....		\$
	Bags Cement at.....		\$
	Paving Brick } Mack } Red } Asphalt } at.....		\$
	Lead Joints at.....		\$
	Leadite Joints at.....		\$
7	Hrs. Foreman at.....		\$ 4.37
1	Hrs. Common Labor at..... @.50		\$ .50
17	Hrs. Common Labor at.....		\$ 6.91
	Hrs. Mason at.....		\$
	Hrs. Mason's Helper at.....		\$
3	Hrs. Compressor at.....		\$ 4.50
	Compensation Ins.....		\$ .36
	Trucking.....		\$ 1.10
	Builders' Use of Water Patch.....		\$ 5.00
Total			\$ 30.53

30-2 68  
 Labor and Material Report June 27 2 1970

54 prospect. etc.

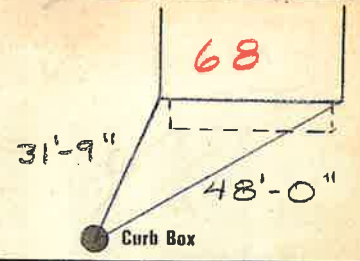

6 Main Elev of Main at tap 4 1/2  
 Gate at TAX ID # 303.13-20-1 Gate at

● Curb Box

old reconnected  
 Re measured 6-16-78  
 SET  
 3/4" COPPER  
 6' TO MAIN