

LABOR AND MATERIALS

1	Copper	} Connection	3/4"	\$	2.41
1	Lead				
1	Curb	} Cock Valve T.S. & V.	3/4" in.	\$	3.41
1	Service box				
	Old returned	} Short 3 1/2 x 4 1/2 Long 4 1/2 x 5 1/2 Buff or Rdway		\$	4.18
28	Ft. 3/4 in.				
		} Copper C.I. C.I.	} Pipe at 40	\$	11.20
	Nipples	in. at		\$	
	Bushings	to in. at		\$	
	Red'g } Inc'g }	Coupl'gs	to in. at	\$	
	Union	in. at		\$	
	Meter	in. at		\$	
	Lead Joints	at		\$	
	Compound Joints	at		\$	
	Maintenance Foreman			\$	
	Hrs. Water Maint. Man-1	at		\$	
9	Hrs. Water Maint. Man-2	at 1.24		\$	11.16
	Hrs. Garage Foreman	at		\$	
20	Hrs. Labor	at 1.13		\$	22.60
	Hrs. Compressor	at		\$	
	Compensation Ins. at \$2.961 per C.			\$	1.30
	Trucking			\$	1.50
	Pav't Patch			\$	30.80
	Tap by Girasole	629-54		\$	
	O'head			\$	
				\$	88.56


5776

39-54

Prospect
St. Pl. Ave. No. 71
Name of Owner

Vitagliano

Labor and Mat'l. Report June 29 1954

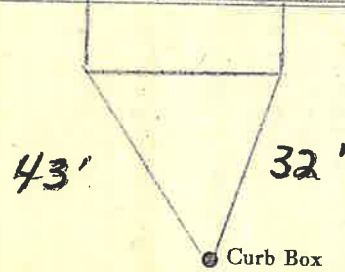

4" Main Elev. of Main at tap 5'

Gate at • Gate at

28' to main

3/4" Copper • Curb Box

TAX ID # 303.13-21-23