

LABOR AND MATERIALS


1	Copper	{ Connection	3/4"	\$ 2.76
1	Lead	{		
1	Curb	{ Cock Valve	3/4" in.	\$ 3.49
		{ T.S. & V.		
1	Service box	{ Short 3 1/2 x 4 1/2		
	Old returned	{ Long 4 1/2 x 5 1/2		
		{ Buff or Rdway		\$ 4.75
8	3/4 in.	{ Copper	Pipe at 35	\$ 280
		{ G.I.		
		{ C.I.		
	Nipples	in. at		\$
	Bushings	to in. at		\$
	Red'g	{ Coupl'gs	to in. at	\$
	Inc'g	{		
	Union	in. at		\$
	Meter	in. at		\$
	Lead Joints at			\$
	Compound Joints at			\$
3	Hrs. Water Maint. Man-1	at 1.34		\$ 4.02
1	Hrs. Water Maint. Man-2	at 1.24		\$ 1.24
18	Hrs. Labor	at 1.13		\$ 20.34
1 1/2	Hrs. Labor	at 1.44		\$ 2.16
1 1/2	Hrs. Compressor	at 1.50		\$ 2.25
	Compensation Ins. at	\$ 3.706 per C.		\$.99
	Trucking			\$ 1.00
	Pav't Patch			\$ 10.13
				\$
				\$
				\$
	O'head			\$
				\$ 44.35

Top made June 12 52
by Warsinski

74
Prospect St. Pl. 72 Ave. No.

Name of Owner
Ed. Jones

Labor and Mat'l. Report June 12 1952

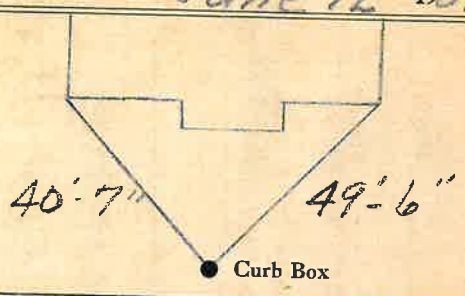

6" Main Elev. of Main at tap 4 1/2'
Gate at ● Gate at ●

TAX ID# 303.13-20-2

● Curb Box
3/4" copper
8' to main