

LABOR AND MATERIALS


1	Copper Lead	Connection	3/4"	\$	2.71
1	Curb	Cock Valve	3/4 in.	\$	3.83
1	Service box	Short 3 1/2 x 4 1/2			
	Old returned	Long 4 1/2 x 5 1/2			
		Buff or Rdway		\$	4.69
36	3/4 in.	Copper	Pipe at	45	\$ 16.20
		C.I.			
		C.I.			
	Nipples	in. at		\$	
	Bushings	to in. at		\$	
	Red'g Inc'g	Coupl'gs to in. at		\$	
	Union	in. at		\$	
	Meter	in. at		\$	
	Lead Joints at			\$	
	Compound Joints at			\$	
4	Maintenance Foreman	1.51	\$	6.04	
	Hrs. Water Maint. Man-1 at		\$		
2	Hrs. Water Maint. Man-2 at	1.24	\$	2.48	
	Hrs. Garage Foreman at		\$		
14	Hrs. Labor— at	1.13	\$	15.82	
2	Hrs. Compressor at	1.50	\$	3.00	
	Compensation Ins. at \$	4.29 per C	\$	1.04	
	Trucking		\$	1.50	
	Pav't Patch		\$	9.45	
	Tap by Gifford	12-8-54	\$		
	O'head		\$		
			\$	66.76	

24.34

Prospect St. Pt. Ave. No. 75

Name of Owner Ross.

Labor and Mat'l. Report Dec. 8 1954

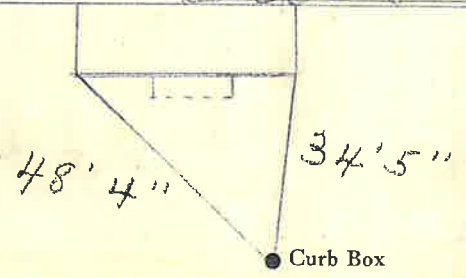

6" Main Elev. of Main at tap 5'

Gate at • Gate at •

36' to main

3/4" copper • Curb Box

TAX ID# 303.13-21-21