


Labor and Materials

1	Copper	Connection	3/4	\$	2.70
1	Curb	Cock Valve	3/4	\$	2.34
1	Service Box	Short 2 1/2" Long 4 1/2 x 5 1/2" Butt or Redway		\$	1.55
8	Ft.	Copper Cast Iron Pipe at	3/4	\$	2.16
	Nipples	in. at		\$	
	Bushings	to in. at		\$	
	Red'g Inc'g	Couplings to in. at		\$	
	Union	in. at		\$	
	Meter	in. at		\$	
	Lbs. Br. Stone	at		\$	
	Lbs. Sand	at		\$	
	Bags Cement	at		\$	
	Paving Brick	Mack Red Asphalt at		\$	
	Lead Joints	at		\$	
	Leadite Joints	at		\$	
3	Hrs. Foreman	at		\$	1.88
16	Hrs. Common Labor	at		\$	7.20
	Hrs. Common Labor	at		\$	
	Hrs. Mason	at		\$	
	Hrs. Mason's Helper	at		\$	
	Hrs. Compressor	at		\$	
	Compensation Ins.			\$	28
	Trucking			\$	1.00
	Builders' Use of Water	Patch		\$	5.00
Total \$					24.16

30-31 76  
 Labor and Material Report April 28, 1930

60 Prospect St.

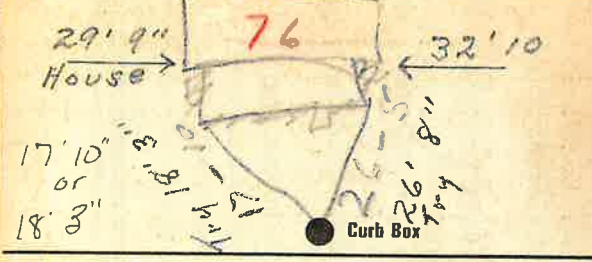

● Curb Box

old tape dis

com

TAX ID # 303.13-20-3

3/4"

8'