

Labor and Materials

Copper	} Connection	7	\$ 1.46	
Lead				
Curb	} Cock Valve } T. S. & V. }		\$ 1.93	
Service Box		} Short 3 1/2 x 4 1/2 } Long 4 1/2 x 5 1/2 }		\$ 1.77
Old returned				
5 Ft. in.	} Copper } Galv-Iron } Cast-Iron }	3	\$ 1.76	
Nipples				
Bushings				
Red'g Inc'g	} Conplings			
Union				
Meter				
Lead Joints				
Leadite Joints				
Hrs. Foreman				
2 Hrs. Chauffeur		6 1/2	\$ 1.25	
4 Hrs. Tapper		6 1/2	\$ 2.50	
8 Hrs. Labor		4 1/2	\$ 3.60	
Hrs. Labor			\$ 7.90	
Hrs. Compressor				
Compensation Ins.			\$ 23	
Trucking			\$ 1.00	
Builders Use of Water		Patch	\$ 5.00	
T. H. Hessel				
			\$ 20.50	


158-1937

St. 80
Pl. 62
Ave. No.

Prospect St.

Name of Owner

Labor and Mat'l. Report

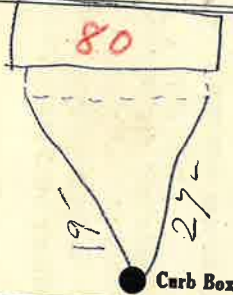

● Curb Box

6 Main Iron Main Elev. of Main at tap 4 1/2

Gate at TAX 10 # 303.13-20-4 Gate at

● Curb Box

Old tap disconnected

8' to main