

Labor and Materials

1	Copper Head	Connection	2 4		\$ 1.46
1	Curb	Cock Valve T.S. Box	3 4		\$ 1.93
1	Service Box Old returned	Short 3 1/2 x 4 1/2 Long 4 1/2 x 5 1/2 Buff. or Rdway			\$ 1.77
10	Ft. 3/4 in.	Copper Galv Iron Cast Iron	Pipe at		\$ 2.20
	Nipples	in. at			\$
	Bushings	to in. at			\$
	Red'g In'g	Conplings to in. at			\$
	Union	in. at			\$
	Meter	in. at			\$
	Lead Joints	at			\$
	Leadite Joints	at			\$
	Hrs. Foreman	at			\$
7	Hrs. Chauffeur	at 6 1/2 hr			\$ 4.38
1.2	Hrs. Tapper	at 6 1/2 hr			\$ 7.50
	Hrs. Labor	at			\$
	Hrs. Labor	at			\$
	Hrs. Compressor	at			\$
	Compensation Ins.				\$ 37
	Trucking				\$ 1.00
	Builders Use of Water	Patch			\$ 5.00
	Taps made by Penac				\$
	They saw a house here				\$
	adj one to in				\$
					\$
					\$
					\$ 25.61


9 2 - 1937

30
Prospect

St. Pl. Ave. No. 24

Name of Owner
S. Verman

Labor and Mat'l. Report Aug 6 1937

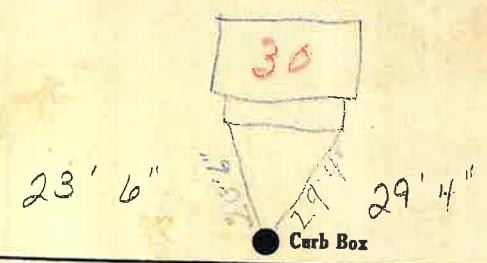

4 Main Elev. of Main at tap 5

Gate at TAX ID# 303.17-14-2 Gate at

● Curb Box

New Hoare
old Taps shot off

3/4" Copper W
10' to main