

Labor and Materials


Copper } Connection	3	\$ 2.70
Curb } Cock	3	\$ 2.39
Value } in	1/4	
P.S. & V. }		
Service Box } Short 3/4x4 1/2		\$ 1.45
Old returned } Long 4 1/2x5 1/2		
	Buff. or Rdway	
Ft. in. } Copper	7	\$ 1.62
	Galv. Iron	
	Cast Iron	
Nipples	in. at	\$
Bushings	to in. at	\$
Red'g } Couplings	to in. at	\$
Inc'g }		
Union	in. at	\$
Meter	in. at	\$
Lbs. Br. Stone	at	\$
Lbs. Sand	at	\$
Bags Cement	at	\$
Paving Brick } Mack	at	\$
	Red	
	Asphalt	
Lead Joints	at	\$
Leadite Joints	at	\$
3 Hrs. Foreman	at	\$ 1.88
12 Hrs. Common Labor	at	\$ 5.40
Hrs. Common Labor	at	\$
Hrs. Mason	at	\$
Hrs. Mason's Helper	at	\$
Hrs. Compressor	at	\$
Compensation Ins		\$.23
Trucking		\$ 1. -
Builders' Use of Water	Patch	\$ 5. -
Total \$		21.67

30-43 82

Labor and Material Report

May 16 1936

64 Prospect St.

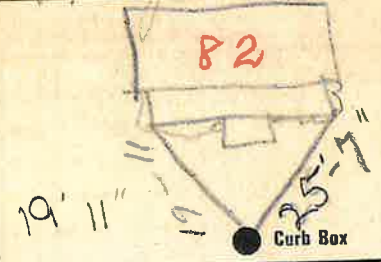

6 Main Elev of Main at tap 5'

Gate at TAX ID # 303.13-20-5 Gate at

● Curb Box

Old tap disconnected

3/4" copper
6' to MAIN