

LABOR AND MATERIALS

1	Copper	} Connection $\frac{3}{4}$ "	\$
1	Lead		
1	Curb	} $\frac{3}{4}$ " oriseat.	\$
	Valve		
	T.S. & V.		
1	Service box	} Short $3\frac{1}{2}$ x $4\frac{1}{2}$	
	Old returned		Long $4\frac{1}{2}$ x $5\frac{1}{2}$
		Buff or Rdway	\$
35	Ft. $\frac{3}{4}$ " in.	} Pipe at	\$
			Copper
		G.I.	
		G.I.	
	Nipples	in. at	\$
	Bushings	to in. at	\$
	Red'g	} Coupl'gs to in. at	\$
	Inc'g		
	Union	in. at	\$
	Meter	in. at	\$
	Lead Joints	at	\$
	Compound Joints	at	\$
	Maintenance Foreman		\$
	Hrs. Water Maint. Man-1	at	\$
	Hrs. Water Maint. Man-2	at	\$
	Hrs. Garage Foreman	at	\$
	Hrs. Labor	at	\$
	Hrs. Compressor	at	\$
	Compensation Ins. at \$	per C	\$
	Trucking		\$
	Pav't Patch		\$
	Tap by Gissordy & Co.		\$
	5-23-63.		\$
	O'head		\$
			\$

Prospect


St. Pl. 83-85  
Ave. No.

Name of Owner

Tony A. Joseph

Labor and Mat'l. Report

May 23 19 63

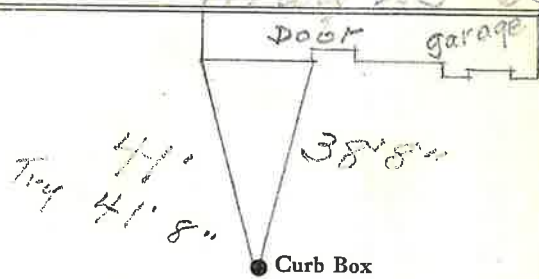

6" C.I. Main

Elev. of Main at tap 5'

Gate at • Gate at

#85 TAX ID # 303.13-21-19

• Curb Box

3/4" copper  
35' to main