

LABOR AND MATERIALS


1	Copper	{ Connection	$\frac{3}{4}$ "	\$ 2.76
1	Lead	{		
1	Curb	{ Cock Valve	$\frac{3}{4}$ in.	\$ 3.49
		{ T.S. & V.		
1	Service box	{ Short $3\frac{1}{2} \times 4\frac{1}{2}$		
	Old returned	{ Long $4\frac{1}{2} \times 5\frac{1}{2}$		
		{ Buff or Rdway		\$ 4.75
8	Ft. $\frac{3}{4}$ "	{ Copper	Pipe at 35	\$ 2.80
		{ G. I.		
		{ G. I.		
	Nipples	in. at		\$
	Bushings	to in. at		\$
	Red'g	{ Coupl'gs to in. at		\$
	Inc'g			\$
	Union	in. at		\$
	Meter	in. at		\$
	Lead Joints	at		\$
	Compound Joints	at		\$
5	Hrs. Water Maint. Man	1 at		\$ 6.70
	Hrs. Water Maint. Man	2 at		\$
$\frac{1}{2}$	Hrs. Labor	7 man at 1.44		\$ 7.20
16	Hrs. Labor	at 1.13		\$ 18.08
$\frac{1}{2}$	Hrs. Compressor	at 1.50		\$ 2.25
	Compensation Ins.	at \$3.706 per C.		\$.95
	Trucking			\$ 1.00
	Pav't Patch			\$ 10.13
				\$
				\$
				\$
	O'head			\$
				\$ 53.63

Top made - June 12-52
by Worsman

Prospect St. Pl. Ave. No. 84

Name of Owner Kelleher

Labor and Mat'l. Report June 12, 1952

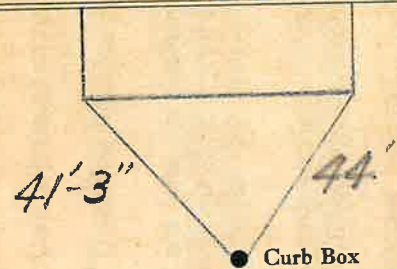

6" Main Elev. of Main at tap 9 1/2
Gate at • Gate at

TAX ID# 303.13-20-6

• Curb Box

$\frac{3}{4}$ " COPPER
8' TO MAIN