

## LABOR AND MATERIALS

1	Copper / Connection	3/4	\$	2.87
	Lead			
1	Curb { Cock Valve } T. S. & V. {	3/4 in.	\$	3.62
1	Service box Old returned	Short 3 1/2 X 4 1/2 } Long 4 1/2 X 5 1/2 } Buff or Rdway	\$	4.65
32	Ft. 3/4 in.	Copper G. I. C. I. } Pipe at	37	\$ 10.24
	Nipples	in. at	\$	
	Bushings	to in. at	\$	
	Red'g Inc'g Coupl'gs	to in. at	\$	
	Union	in. at	\$	
	Meter	in. at	\$	
	Lead Joints at		\$	
	Compound Joints at		\$	
7	Hrs. Water Maint. Man-1 at	1.12	\$	7.84
1.2	Hrs. Water Maint. Man-2 at	1.02	\$	12.24
1.5	Hrs. Labor- at	91	\$	13.65
	Hrs. Labor- at		\$	
	Hrs. Compressor at		\$	
	Compensation Ins. at \$ 2.18 per C.		\$	.74
	Trucking		\$	2.50
	Pav't Patch		\$	14.85
	Tops by Watson's		\$	
	O'head		\$	
			\$	72.73

12


St. Prospect  
Pl. Ave. No. 89

Name of Owner

Duggan

Labor and Mat'l. Report

April 5 19 49

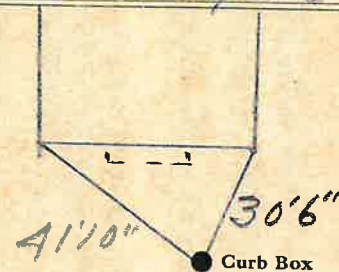

6 Main Elev. of Main at tap 3

Gate at ● Gate at ●

TAX ID# 303.13-21-18

● Curb Box

3/4" copper  
32' to MAIN