

Labor and Materials

Copper } Connection.....	\$
Lead }	\$
Curb { Cock }	\$
{ Valve }	\$
{ T. S. & V. }	\$
Service Box { Short 3 1/2 x 4 1/2 }	\$
Old returned { Long 4 1/2 x 5 1/2 }	\$
{ Buff. or Rdway }	\$
Ft. in. { Copper } Pipe at.....	\$
{ Galv. Iron }	\$
{ Cast Iron }	\$
Nipples..... in. at.....	\$
Bushings..... to..... in. at.....	\$
Red'g } Couplings..... to..... in. at.....	\$
Inc'g }	\$
Union..... in. at.....	\$
Meter..... in. at.....	\$
Lbs. Br. Stone at.....	\$
Lbs. Sand at.....	\$
Bags Cement at.....	\$
Paving Brick { Mack } at.....	\$
{ Red }	\$
{ Asphalt }	\$
Lead Joints at.....	\$
Leadite Joints at.....	\$
Hrs. Foreman at.....	\$
Hrs. Common Labor at.....	\$
Hrs. Common Labor at.....	\$
Hrs. Mason at.....	\$
Hrs. Mason's Helper at.....	\$
Hrs. Compressor at.....	\$
Compensation Ins.....	\$
Trucking.....	\$
Builders' Use of Water.....	\$
Total \$.....	


Labor and Material Report

July 12

1926

90

no 70 Prospect St

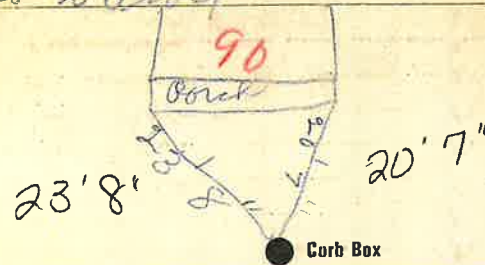

6 Main

Elev. of Main at tap ↓

Gate at ●

● Gate at

● Curb Box

TAX ID# 303.13-20-8