


34 tap at Prospect St.

937 DIX

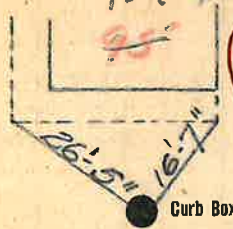

see 93
187 DIX
AV

Curb Box

TAX ID #303.13-21-15

6 Main Elev. of Main at tap Gate at Gate at

Curb Box

Tap on Prospect St;
3/4" Copper
30' to MAIN

Labor and Materials

1	Lead Connection	\$
	Curb Cock	\$
	Service Box { Short 3 1/2 x 4 1/2	\$
	Old returned { Long 4 1/2 x 5 1/2	\$
	Buffalo	\$
30	Ft. in. G.I. Pipe at	\$
	Nipples in. at	\$
	Bushings to in. at	\$
	Red'g Coup. to in. at	\$
	Inc'g Coup. to in. at	\$
	Union in. at	\$
1	Motor in. at Brass coupling	\$
	Cu. Yds. Br. Stone at	\$
	Cu. Yds. Sand at	\$
	Bags Cement at	\$
	Paving Brick { Mack Red Asphalt } at	\$
12	Hrs. Foreman at	\$
40	Hrs. Common Labor at	\$
	Hrs. Mason at	\$
13	Hrs. H.A.V.E.N.S. at	\$
3	Hrs. O.C.M.P.R.E.S.O.R. at	\$
	Builders' Use of Water	\$
12	sticks dynamite at	\$
7	Electric Cords at	\$
	Tackle 1.00 at	\$
	Total	\$