


LABOR AND MATERIALS

1	Copper	} Connection	3/4"	\$
	Lead			
1	Curb	} 3/4 in.	\$	
	Cock			
	Valve			
		T. S. & V.		
1	Service box	} Short 3 1/2 x 4 1/2	\$	
	Old returned			
		Long 4 1/2 x 5 1/2		
		Buff or Rdway		
10	3/4 in.	} Copper	\$	
		G. I.		
		C. I.		
	Nipples	in. at	\$	
	Bushings	to in. at	\$	
	Red'g	} Coupl'gs	to in. at	\$
	Inc'g			
	Union	in. at	\$	
	Meter	in. at	\$	
	Lead Joints	at	\$	
	Compound Joints	at	\$	
	Maintenance Foreman		\$	
	Hrs. Water Maint. Man-1	at	\$	
	Hrs. Water Maint. Man-2	at	\$	
	Hrs. Garage Foreman	at	\$	
	Hrs. Labor	at	\$	
	Hrs. Compressor	at	\$	
	Compensation Ins. at \$	per C	\$	
	Trucking		\$	
	Pay't Patch		\$	
	Tap made Aug 14 57		\$	
	by Gifford & Co		\$	
			\$	
	O'head		\$	
			\$	

Prospect St. Ave. No. 32

Name of Owner Brady

Labor and Mat'l. Report Aug 14 1957

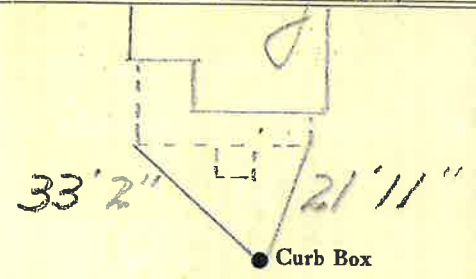

6" Main Elev. of Main at tap 4 1/2'

Gate at • Gate at

TAX ID # 303.17-14-3

• Curb Box

Old service Disconnected at Main Aug 15 57

LSM-5C-2-5 56 3/4" Copper 10' to MAIN