


✓ Prouy's Island

St. Pl. Ave. No. 5

Name of Owner ?
Union-Camp Paper Co.

Measured in
Labor and Mat'l. Report Dec. 8 1958

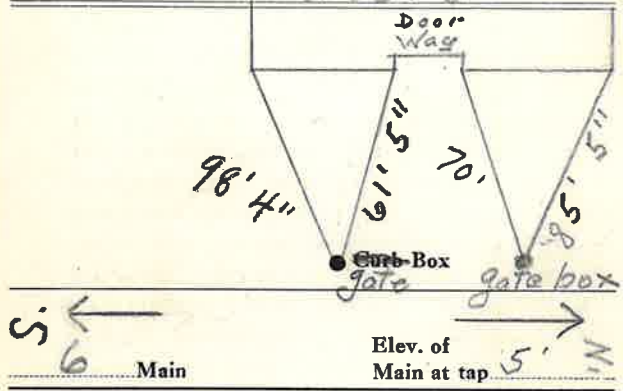

Gate at • Gate at
3/5/7 TAX ID # 309.16-23-9


• Curb Box
Sprinkler System.
2-6"-gates.
old. Bldg.
6"-C.I. 1958.

LSM-5C-2.5 56

✓ Prouy's Island

St. Pl. Ave. No. 5

Name of Owner ?
Union-Camp Paper Co.
Measured in
Labor and Mat'l. Report Dec. 8 1958

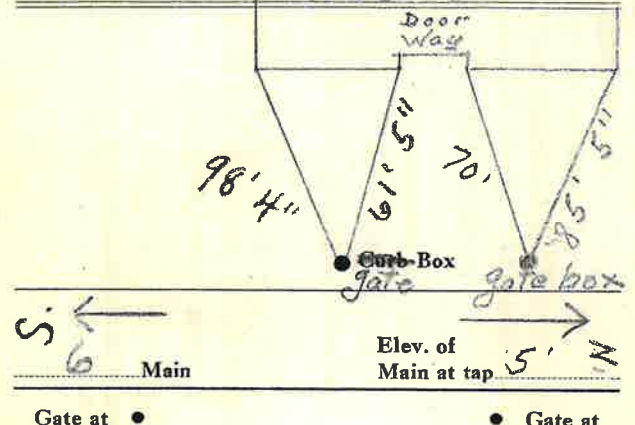

Gate at • Gate at
3/5/7 TAX ID # 309.16-23-9

• Curb Box
Sprinkler System.
2-6"-gates.
old. Bldg.
6"-C.I. 1958.

LSM-5C-2.5 56

LABOR AND MATERIALS

Poured Tapping Sleeve

1	Copper- Lead- Connection		\$
1	Curb } Cock } Valve } T. S. & V. }	6 in. M.J.	\$
1	Service box Old-returned	{ Short 3 1/2 x 4 1/2 Long 4 1/2 x 5 1/2 Buff or Rdway }	\$
	Ft. in.	{ Copper } { G. I. } { C. I. }	Pipe at \$
	Nipples	in. at	\$
	Bushings	to in. at	\$
	Red'g Inc'g } Coupl'gs	to in. at	\$
	Union	in. at	\$
	Meter	in. at	\$
	Lead Joints	at	\$
	Compound Joints	at	\$
	Maintenance Foreman		\$
	Hrs. Water Maint. Man-1	at	\$
	Hrs. Water Maint. Man-2	at	\$
	Hrs. Garage Foreman	at	\$
	Hrs. Labor	at	\$
	Hrs. Compressor	at	\$
	Compensation Ins.	at \$ per C	\$
	Trucking		\$
	Pav't Patch		\$
	Tap by Miller + Co.		\$
		6-3-64.	\$
	O'head		\$
			\$


Pruyn Island

St. Pl. Ave. No. *5*

Name of Owner

Union Bag - Camp

Labor and Mat'l. Report *June 3 1964.*

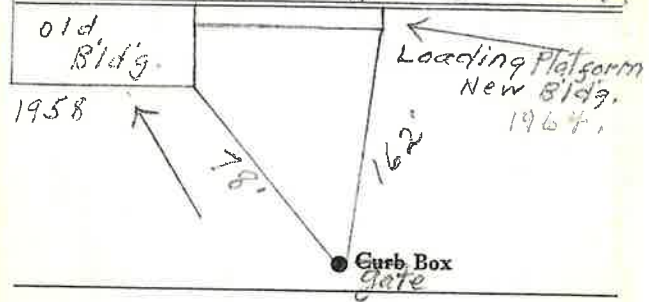

6" Main

Elev. of Main at tap *5'*

Gate at ●

● Gate at

● Curb Box

*6" Tap For Sprinkler System.
New Bldg 1964.*