

LABOR AND MATERIALS

1 Copper } Connection 1 1/2" \$  
 Lead }  
 1 Curb } Cock } 2 in. brass \$  
 Valve }  
 T.S. & V. }  
 1 Service box } Short 3 1/2 x 4 1/2 }  
 Old returned } Long 4 1/2 x 5 1/2 }  
 Buff or Rdway } }  
 40 Ft. 2 in. } Copper } Pipe at \$  
 } }  
 Nipples in. at \$  
 Bushings to in. at \$  
 Red'g }  
 Inc'g } Coupl'gs to in. at \$  
 Union in. at \$  
 Meter in. at \$  
 1 Lead Joints at 2" - 3pc Coupling \$  
 Compound Joints at \$  
 Maintenance Foreman \$  
 Hrs. Water Maint. Man - 1 at \$  
 Hrs. Water Maint. Man - 2 at \$  
 Hrs. Garage Foreman at \$  
 Hrs. Labor at \$  
 Hrs. Compressor at \$  
 Compensation Ins. at \$ per C \$  
 1 Trucking 2" Brass Elbow \$  
 Pav't Patch \$  
 TAP MADE BY Beeche \$  
 + Co \$  
 O'head July-16-1973 \$


St. \_\_\_\_\_  
 Pl. \_\_\_\_\_  
 Ave. No. \_\_\_\_\_

PRYNES ISLAND

Name of Owner

Deluxe Ready Mix North Inc

Labor and Mat'l. Report July 16 1973

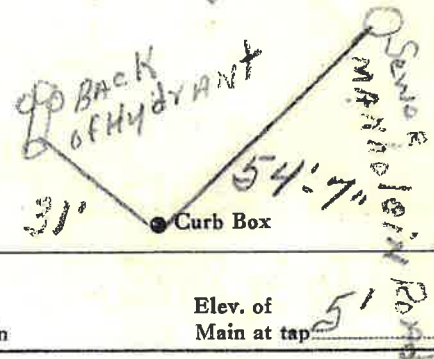

8" Main Elev. of Main at tap 5'

Gate at • Gate at •

• Curb Box

2" COPPER  
 40' TO MAIN