

LABOR AND MATERIALS

Copper	} Connection	_____	\$ _____	
Lead				
Curb	} Cock	_____ in.	\$ _____	
				} Valve
Service box	} Short 3½ x 4½	_____	\$ _____	
				Old returned
Ft. _____ in.	} Copper	Pipe at _____	\$ _____	
				} G. I.
Nipples	_____ in. at _____	\$ _____		
Bushings	_____ to _____ in. at _____	\$ _____		
Red'g	} Coupl'gs	_____ to _____ in. at _____	\$ _____	
Inc'g				
Union	_____ in. at _____	\$ _____		
Meter	_____ in. at _____	\$ _____		
_____			\$ _____	
Compound Joints	at _____	\$ _____		
Maintenance Foreman		\$ _____		
Hrs. Water Maint. Man-1	at _____	\$ _____		
Hrs. Water Maint. Man-2	at _____	\$ _____		
Hrs. Garage Foreman	at _____	\$ _____		
Hrs. Labor	at _____	\$ _____		
Hrs. Compressor	at _____	\$ _____		
_____			\$ _____	
Trucking		\$ _____		
Pav't Patch		\$ _____		
_____		\$ _____		
_____		\$ _____		
_____		\$ _____		
_____		\$ _____		


Pryon Island 15

MURRAY

St. \_\_\_\_\_  
Pt. \_\_\_\_\_  
Ave. No. \_\_\_\_\_

Name of Owner Dan FOSS  
~~NELES (FORMERLY KAMMYR)~~

Labor and Mat'l. Report 19 78

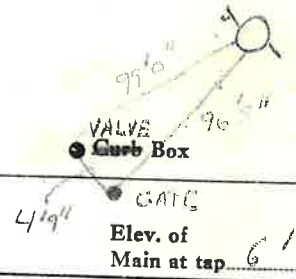

8 Main Elev. of Main at tap 61  
Gate at • Gate at •

• Curb Box

TAP TO BE USED FOR  
FUTURE EXPANSION - TAP  
ON KAMMYR DR.