

LABOR AND MATERIALS

Copper	} Connection		\$	
Lead				
Curb	} Cock Valve T. S. & V.	in.	\$	
Service box		} Short 3½ x 4½ Long 4½ x 5½		
Old returned				\$
Ft.	} Copper G. I. C. I.	Pipe at	\$	
in.				
Nipples	in. at		\$	
Bushings	to in. at		\$	
Red'g Inc'g	} Coupl'gs	to in. at	\$	
Union		in. at	\$	
Meter	in. at		\$	
Compound Joints	at		\$	
Maintenance Foreman			\$	
Hrs. Water Maint. Man	1 at		\$	
Hrs. Water Maint. Man	2 at		\$	
Hrs. Garage Foreman	at		\$	
Hrs. Labor	at		\$	
Hrs. Compressor	at		\$	
Trucking			\$	
Pav't Patch			\$	
			\$	
			\$	
			\$	
			\$	

DRYON ISLAND 15

St. Pt. 45 Ave. No.


MURRAY

Name of Owner DAN FLOSS P

NELES (FORMERLY KAMYR)

Labor and Mat'l. Report

1978

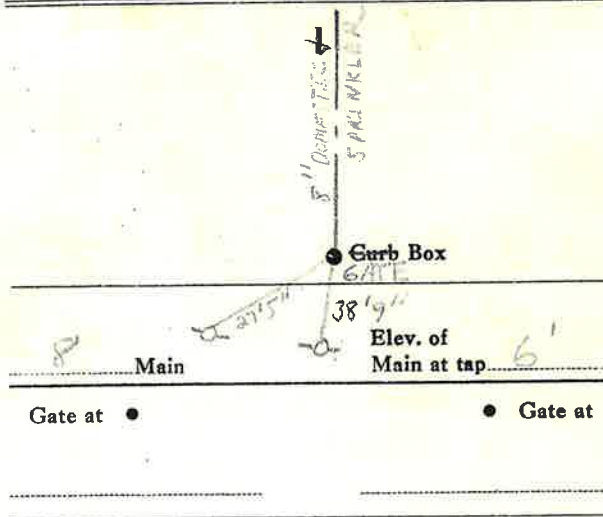

Gate at •

• Gate at

• Curb Box

TAP ON KAMYR DR.