

LABOR AND MATERIALS


Copper	} Connection _____	in.	\$ _____
Lead			
Curb	} Cock Valve T. S. & V. }	in.	\$ _____
Service box			
Old returned			
	{ Short 3½ x 4½ } { Long 4½ x 5½ }		\$ _____
Ft. 6 in.	{ Copper C.I. C.I. }	Pipe at _____	\$ _____
Nipples _____	in. at _____		\$ _____
Bushings _____	to _____	in. at _____	\$ _____
Red'g } Inc'g }	} Coupl'gs _____	to _____	in. at _____
Union _____			
Meter _____	in. at _____		\$ _____
Compound Joints at _____			\$ _____
Maintenance Foreman _____			\$ _____
Hrs. Water Maint. Man—1 at _____			\$ _____
Hrs. Water Maint. Man—2 at _____			\$ _____
Hrs. Garage Foreman _____	at _____		\$ _____
Hrs. Labor— _____	at _____		\$ _____
Hrs. Compressor at _____			\$ _____
Trucking _____			\$ _____
Pav't Patch _____			\$ _____
			\$ _____
			\$ _____
			\$ _____
			\$ _____

PRUYN'S ISLAND

MURRAY + KAMYL, DR. ^{St.} ^{Pl.} _{Ave. No.}

Name of Owner
(FORMERLY KAMYL) - AHLSTROM (1999)

Labor and Mat'l. Report 19 90

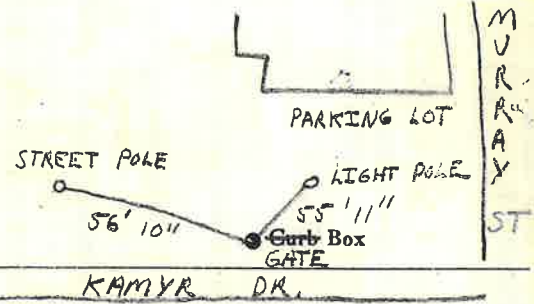

Main Elev. of Main at tap
Gate at • Gate at

• Curb Box
6" copper