


LABOR AND MATERIALS

Copper	} Connection		\$
Lead			
Curb	} Cock Valve T. S. & V.	in.	\$
Service box		} Short 3½ x 4½ Long 4½ x 5½	
Old returned			
Ft. 8 in.	} Copper G.I. C.I.	Pipe at	\$
Nipples		in. at	\$
Bushings	to in. at	\$	
Red'g Inc'g	} Coupl'gs	to in. at	\$
Union		in. at	\$
Meter	in. at	\$	
			\$
Compound Joints	at	\$	
Maintenance Foreman		\$	
Hrs. Water Maint. Man-1	at	\$	
Hrs. Water Maint. Man-2	at	\$	
Hrs. Garage Foreman	at	\$	
Hrs. Labor	at	\$	
Hrs. Compressor	at	\$	
		\$	
Trucking		\$	
Pav't Patch		\$	
		\$	
		\$	
		\$	
		\$	

PROYN'S ISLAND ~~St~~ ~~Pl~~ Ave. No. _____

Name of Owner
NAMIC

Labor and Mat'l. Report MARCH 12 1985

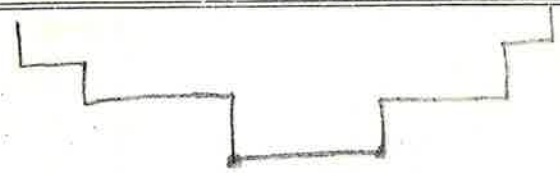

48'7" 18'8"

● Curb Box
GATE

	Main	Elev. of Main at tap
Gate at ●		● Gate at

● Curb Box

8" copper