


LABOR AND MATERIALS

1	Copper	} Connection	3/4"	\$	
1	Lead				
1	Curb	} Valve	3/4 in.	\$	
				T.S. & V.	
1	Service box	} Short 3 1/2 x 4 1/2		\$	
	Old returned			Long 4 1/2 x 5 1/2	
		Buff. or Rdway		\$	
11	Ft. 3/4 in.	} Pipe at		\$	
				Copper	
				G.I.	
		C.I.		\$	
	Nipples	in. at		\$	
	Bushings	to in. at		\$	
	Red'g	} Coupl'gs	to in. at	\$	
	Inc'g				
	Union	in. at		\$	
	Meter	in. at		\$	
	Lead Joints	at		\$	
	Compound Joints	at		\$	
	Maintenance Foreman			\$	
	Hrs. Water Maint. Man-1	at		\$	
	Hrs. Water Maint. Man-2	at		\$	
	Hrs. Garage Foreman	at		\$	
	Hrs. Labor	at		\$	
	Hrs. Compressor	at		\$	
	Compensation Ins. at \$	per C		\$	
	Trucking			\$	
	Pav't Patch			\$	
	Tap by Gifford			\$	
	10-21-57			\$	
	O'head			\$	

St. Pulver  
 Pl. 2  
 Ave. No. 2  
 Name of Owner \_\_\_\_\_

Labor and Mat'l. Report Oct 21 1957

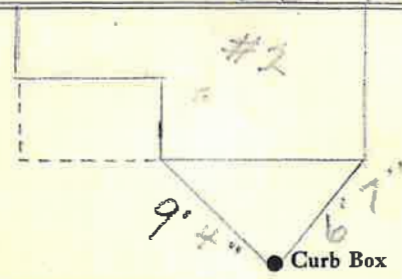

6" Main Elev. of Main at tap 5'

Gate at • Gate at •

TAX ID # 302.15-14-11

• Curb Box

3/4" Copper  
 11' to main