

LABOR AND MATERIALS

1	Copper	Connection	<u>3/4</u>	\$
	Lead			
1	Curb	Cock Valve	<u>3/4</u> in.	\$
		T.S. & V.		
1	Service box	Short <u>3 1/2 x 4 1/2</u>		
	Old returned	Long <u>4 1/2 x 5 1/2</u>		
		Buff or Rdway		\$
27	Ft.	Copper	<u>3/4</u> in.	Pipe at \$
		C.I.		
		C.I.		
	Nipples	in.	at	\$
	Bushings	to	in.	at \$
	Red'g			
	Inc'g	Coupl'gs	to in.	at \$
	Union	in.	at	\$
	Meter	in.	at	\$
	Lead Joints	at		\$
	Compound Joints	at		\$
	Maintenance Foreman			\$
	Hrs. Water Maint. Man-1	at		\$
	Hrs. Water Maint. Man-2	at		\$
	Hrs. Garage Foreman	at		\$
	Hrs. Labor-	at		\$
	Hrs. Compressor	at		\$
	Compensation Ins.	at \$	per C	\$
	Trucking			\$
	Pav't Patch			\$
				\$
				\$
				\$
	O'head			\$


Connected to Old hot Tap

Quade

St. Pl. Ave. No. 1

Name of Owner Michael Sterens

Labor and Mat'l. Report 10 / 2 1978

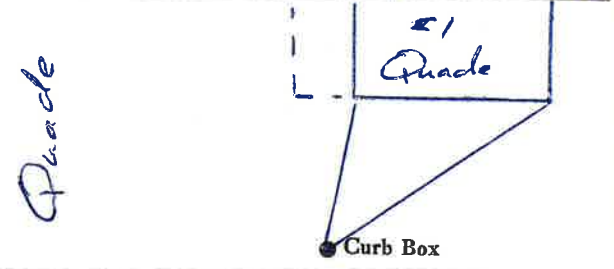

6 Main Elev. of Main at tap 5'

Gate at • Gate at •

TAX ID # 302.19-26-8

• Curb Box
Tap on Sherman Ave
3/4" copper
27' to main