

Labor and Materials


1. Lead	Copper } Connection. $\frac{3}{4}$	\$ 1.48
1. Curb	{ Cock Valve T.S.&V. } $\frac{3}{4}$ in	\$ 1.79
1. Service Box	{ Short $3\frac{1}{2} \times 4\frac{1}{2}$ Long $4\frac{1}{2} \times 6\frac{1}{2}$ Old - returned Bufl. or Rdway }	\$ 1.30
10. Ft. $\frac{3}{4}$ in.	{ Copper Galv. Iron Cast Iron } Pipe at	\$ 1.80
	Nipples ..... in. at	\$
	Bushings ..... to ..... in. at	\$
	Red'g Inc'g } Couplings..... to ..... in. at	\$
	Union..... in. at	\$
	Meter..... in. at	\$
	Lbs. Br. Stone at	\$
	Lbs. Sand at	\$
	Bags Cement at	\$
	Paving Brick { Mack Red Asphalt } at	\$
	Lead Joints at	\$
	Leadite Joints at	\$
2. Hrs.	Foreman at	\$ 1.25
1. Hrs.	Common Labor at Tapper	\$ .50
	Hrs. Common Labor at	\$
	Hrs. Mason at	\$
	Hrs. Masons Helper at	\$
	Hrs. Compressor at	\$
	Compensation Ins	\$ .06
	Trucking	\$ 1.00
	Builders Use of Water No Patch	\$

Total \$ 9.18

Labor and Material Report

Apr 20 1933

40 1/2 Inade St  
Goodman St

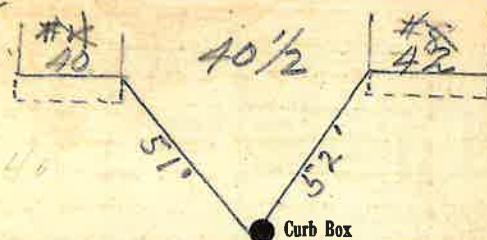

6 Main

Elev. of

Main at tap

44

Gate at

Gate at

● Curb Box

3/4" COPPER  
Tot. 10' to MAIN

Varney,  
Measurements taken  
from #4 & 8 for  
empty lot. #6

O.K. LWT