


Labor and Materials

.....Copper } Connection.....	$\frac{3}{4}$	\$ 2.60
.....Lead }	
.....Curb { Cock }	$\frac{3}{4}$in	\$ 2.27
.....Curb { Valve }	
.....Curb { T.S.&V. }	
.....Service Box { Short $3\frac{1}{2} \times 4\frac{1}{2}$ }	\$ 1.38
.....Old returned { Long $4\frac{1}{2} \times 5\frac{1}{2}$ }	
.....Old returned { Buff. or Rdway }	
10 Ft. $\frac{3}{4}$ " in. { Copper } Pipe at	\$ 1.80
..... { Galv. Iron }	
..... { Cast Iron }	
.....Nipplesin. at	\$
.....Bushingstoin. at	\$
.....Red'g } Couplings.....to.....in.at.....		\$
.....Inc'g }	
.....Union.....in. at	\$
.....Meter.....in. at	\$
.....Lbs. Br. Stone at	\$
.....Lbs. Sand at	\$
.....Bags Cement at	\$
.....Paving Brick { Mack } at	\$
.....Paving Brick { Red }	
.....Paving Brick { Asphalt }	
.....Lead Joints at	\$
.....Leadite Joints at	\$
.....Hrs. Foreman at	\$
.....Hrs. Common Labor at	\$.45
.....Hrs. Common Labor at	\$.40
.....Hrs. Mason at	\$
.....Hrs. Masons Helper at	\$
.....Hrs. Compressor at	\$
.....Compensation Ins	\$.03
.....Trucking	\$ 1.00
.....Builders Use of Water E.J.	\$
Total \$			9.93

32-17 42 Grade St.
 Labor and Material Report *Apr 18* 19

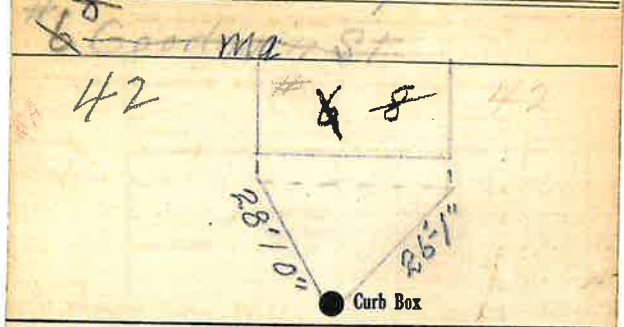

6" Main Elev. of Main at tap *4'*

Gate at ● TAX ID# 302.19-14-4 ● Gate at

● Curb Box

New House

Russell

$\frac{3}{4}$ " copper

10' to main

OK. G.T.