


Labor and Materials

1	Copper } Connection. $3/4$	\$ 1.75
1	Lead } Connection. $3/4$	\$ 1.75
1	Curb { Cock Valve T.S.&V. } $3/4$ in	\$ 1.70
1	Service Box Old-returned { Short $3\frac{1}{2} \times 4\frac{1}{2}$ Long $4\frac{1}{2} \times 5\frac{1}{2}$ Buff. or Rdway }	\$ 1.37
10	Ft. $3/4$ in. { Copper Galv. Iron Cast Iron } Pipe at $12\frac{1}{2}$	\$ 1.25
	Nipples in. at	\$
	Bushings to in. at	\$
	Red'g Inc'g } Couplings to in. at	\$
	Union in. at	\$
	Meter in. at	\$
	Lbs. Br. Stone at	\$
	Lbs. Sand at	\$
	Bags Cement at	\$
	Paving Brick { Mack Red Asphalt } at	\$
	Lead Joints at	\$
	Leadite Joints at	\$
3	Hrs. Foreman at $62\frac{1}{2}$	\$ 1.87
7	Hrs. Common Labor at 50	\$ 1.75
6	Hrs. Common Labor at 45	\$ 2.70
	Hrs. Mason at	\$
	Hrs. Masons Helper at	\$
	Hrs. Compressor at	\$
	Compensation Ins	\$ 21
	Trucking	\$ 1.00
	Builders Use of Water	\$
Total		\$ 17.46



6 Main Elev. of Main at tap 4.4
Gate at Tap 017 Gate at

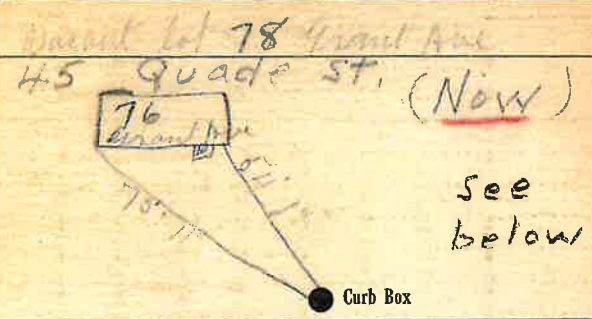