

### LABOR AND MATERIALS

1	Copper	{	Connection	3/4"	\$
1	Lead	{			
1	Curb	{	Cock Valve	3/4" in.	\$
		{	T.S. & V.		
1	Service box	{	Short 3 1/2 x 4 1/2		
	Old returned	{	Long 4 1/2 x 5 1/2		
		{	Buff or Rdway		\$
13	Ft.	{	Copper		
	3/4" in.	{	G. I.	Pipe at	\$
		{	C. I.		
	Nipples		in. at		\$
	Bushings		to in. at		\$
	Red'g	{	Coupl'gs	to in. at	\$
	Inc'g	{			
	Union		in. at		\$
	Meter		in. at		\$
	Lead Joints		at		\$
	Compound Joints		at		\$
	Hrs. Water Maint. Man		1 at		\$
	Hrs. Water Maint. Man		2 at		\$
	Hrs. Labor		at		\$
	Hrs. Labor		at		\$
	Hrs. Compressor		at		\$
	Compensation Ins.		at \$ per C.		\$
	Trucking				\$
	Pav't Patch				\$
					\$
					\$
	O'head				\$
					\$


Top made by Clifford + F. George Nov 6 - 1951

Quade

St. 1  
Pl. 3  
Ave. No. 3

Name of Owner  
Geo. K. Ferguson

Labor and Mat'l. Report Nov 6 1957

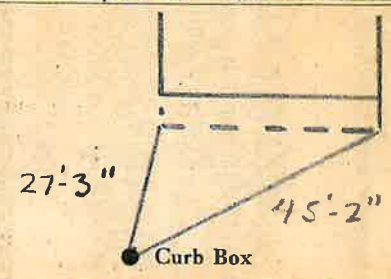

6" Main Elev. of Main at tap 4'  
Gate at • Gate at •

TAX ID # 302.19-26-7

• Curb Box  
3/4" COPPER  
13' TO MAIN