

LABOR AND MATERIALS


| | | | | | |
|-------------|-------------------------|----------------------|-------------|----|-------|
| 1 | Copper | { Connection | 3/4" | \$ | 3.04 |
| | Lead | | | | |
| 1 | Curb | { Cock Valve | 3/4" in. | \$ | 3.54 |
| | | { T. S. & V. | | | |
| <i>Sams</i> | Service box | Short 3 1/2 x 4 1/2 | | \$ | — |
| | Old returned | Long 4 1/2 x 5 1/2 | | \$ | — |
| | | Buff. or Rdway | | \$ | — |
| 13 | Ft. 3/4 in. | Copper | Pipe at 35' | \$ | 4.55 |
| | | G. I. | | | |
| | | C. I. | | | |
| | Nipples | in. at | | \$ | |
| | Bushings | to in. at | | \$ | |
| | Red'g Inc'g | { Coupl'gs to in. at | | \$ | |
| | Union | in. at | | \$ | |
| | Meter | in. at | | \$ | |
| | Lead Joints at | | | \$ | |
| | Compound Joints at | | | \$ | |
| 1 1/2 | Hrs. Water Maint. Man | 1 at AM 136 | | \$ | 20.44 |
| 4 1/2 | Hrs. Water Maint. Man | 2 at 1.13 | | \$ | 50.92 |
| 14 | Hrs. Labor | at 1.02 | | \$ | 14.28 |
| | Hrs. Labor | at | | \$ | |
| | Hrs. Compressor at | | | \$ | |
| | Compensation Ins. at \$ | per C. | | \$ | 57 |
| | Trucking | | | \$ | 1.00 |
| | Pav't Patch | no patch (B. P.) | | \$ | — |
| | | | | \$ | |
| | | | | \$ | |
| | | | | \$ | |
| | O'head | | | \$ | |
| | <i>no chg.</i> | | | \$ | 34.11 |

Top made by Gifford + F George Nov 6 1951

St. Pt. Ave. No. *5*

Name of Owner *Quade*
W. J. Godsil

Labor and Mat'l. Report *Nov 6* 19*51*

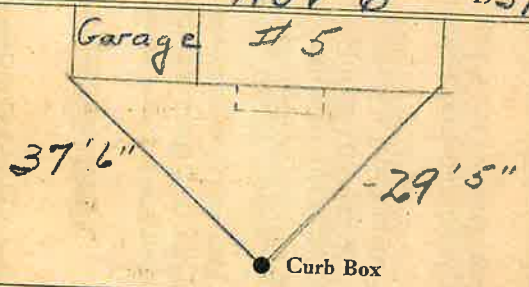

6" Main Elev. of Main at tap *4'*

Gate at ● Gate at ●

TAX ID # *302.19-26-60*

● Curb Box

3/4" copper
13' to main