


LABOR AND MATERIALS

1	Copper	} Connection	3/4"	\$	
	Lead				
1	Curb	} Cock	3/4 in.	\$	
					} Valve
1	Service box	} { Short 3 1/2 x 4 1/2	}	\$	
	Old returned				} { Long 4 1/2 x 5 1/2
40	Ft. 3/4 in.	} { Copper	} Pipe at	\$	
					} { G. I.
	Nipples	in. at	\$		
	Bushings	to in. at	\$		
	Red'g	} Coupl'gs	to in. at	\$	
	Inc'g				
	Union	in. at	\$		
	Meter	in. at	\$		
	Lead Joints	at	\$		
	Compound Joints	at	\$		
	Maintenance Foreman		\$		
	Hrs. Water Maint. Man-1	at	\$		
	Hrs. Water Maint. Man-2	at	\$		
	Hrs. Garage Foreman	at	\$		
	Hrs. Labor	at	\$		
	Hrs. Compressor	at	\$		
	Compensation Ins. at \$	per C	\$		
	Trucking		\$		
	Pay't Patch		\$		
	Tap by G. S. Hardy Co.		\$		
	April 21-60		\$		
	O'head		\$		
			\$		

Quade St. St. Pl. Ave. No. 33

Name of Owner Harry Gleason

Labor and Mat'l. Report April 21 1960

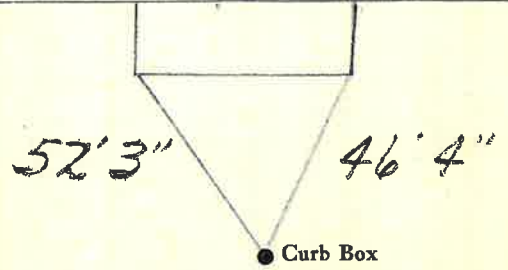

6" Main Elev. of Main at tap 4'
 Gate at • Gate at
 TAX ID # 302.19-15-27

• Curb Box
 3/4" copper
 38' to MAIN