


LABOR AND MATERIALS

1 Copper } Connection ^{3/4"} \$ _____
 -Lead }
 1 Curb } Cock } ^{3/4} in. \$ _____
 } Valve }
 } T. S. & V. }
 1 Service box { Short 3 1/2 x 4 1/2 } \$ _____
 -Old returned { Long 4 1/2 x 5 1/2 } \$ _____
 } Buff or Rdway }
 38 Ft. ^{3/4} in. { Copper } Pipe at \$ _____
 } ~~C.I.~~ }
 } ~~C.I.~~ }
 Nipples _____ in. at \$ _____
 Bushings _____ to _____ in. at \$ _____
 Red'g } Coupl'gs. _____ to _____ in. at \$ _____
 Inc'g }
 Union _____ in. at \$ _____
 Meter _____ in. at \$ _____
 Lead Joints at \$ _____
 Compound Joints at \$ _____
 Maintenance Foreman \$ _____
 Hrs. Water Maint. Man-1 at \$ _____
 Hrs. Water Maint. Man-2 at \$ _____
 Hrs. Garage Foreman _____ at \$ _____
 Hrs. Labor _____ at \$ _____
 Hrs. Compressor at \$ _____
 Compensation Ins. at \$ _____ per C \$ _____
 Trucking \$ _____
 Pav't Patch \$ _____
 Tap by Gissord & Co. \$ _____
 8-11-59 \$ _____
 +12 \$ _____
 O'head \$ _____
 \$ _____

St. _____
 -Pl. _____
 Ave. No. 35

Name of Owner
Quade
John Glass.

Labor and Mat'l. Report Aug. 11 1959

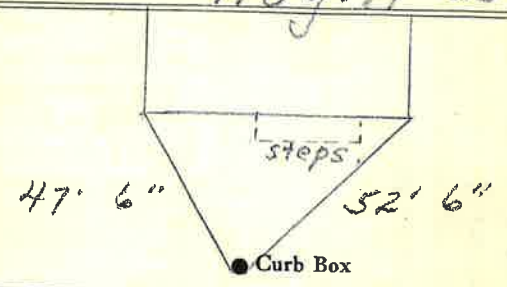

6" Main Elev. of Main at tap 5'
 Gate at • Gate at

TAX ID# 302.19-15-26

• Curb Box