

**Labor and Materials**

1/2	Copper } Connection.....	\$ 320
	Lead } .....	
1	Curb { Cock } .....	\$ 100
	{ Valve } .....	
	{ P.S. & V. } .....	
1	Service Box { Short 3 1/2 x 4 1/2 } .....	\$ 140
	Old returned { Long 4 1/2 x 5 1/2 } .....	
	{ Buff. or Rdway } .....	
5	Ft. .... in. { Copper } Pipe at.....	\$ 152
	{ Galv. Iron } .....	
	{ Cast Iron } .....	
	Nipples..... in. at.....	\$
	Bushings..... to..... in. at.....	\$
	Red'g } Couplings..... to..... in. at.....	\$
	Inc'g } .....	
	Union..... in. at.....	\$
	Meter..... in. at.....	\$
	Lbs. Br. Stone at.....	\$
	Lbs. Sand at.....	\$
	Bags Cement at.....	\$
	Paving Brick { Mack } at.....	\$
	{ Red } .....	
	{ Asphalt } .....	
	Lead Joints at.....	\$
	Leadite Joints at.....	\$
2	Hrs. Foreman at.....	\$ 1.20
4	Hrs. Common Labor at.....	\$ 16.3
	Hrs. Common Labor at.....	\$
	Hrs. Mason at.....	\$
	Hrs. Mason's Helper at.....	\$
	Hrs. Compressor at.....	\$
	Compensation Ins.....	\$ .08
	Trucking.....	\$ 1.20
	Builders' Use of Water.....	\$
Total \$		11.10

**Labor and Material Report**

(13) June 26 1928  
13 Raymond Ave

~~No Measurement~~  
see below

● Curb Box


3/4" copper  
15' to main

Main Elev. of Main at tap

Gate at ● TAX ID # 303.9-10-7 ● Gate at

● Curb Box

New House  
12.18

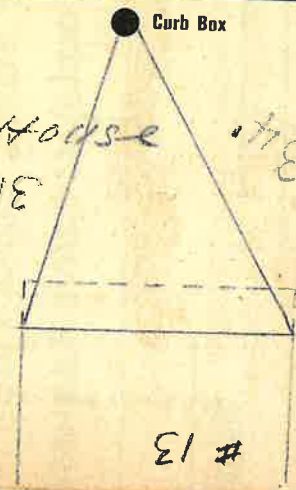

13 #

