


Labor and Materials

Copper } Connection <i>3</i>	\$ 2.60
Lead } Cock Valve } <i>3</i> in.....	\$ 2.30
Curb } T. S. & V. }.....	
Service Box } Short $3\frac{1}{2} \times 4\frac{1}{2}$ }.....	\$ 1.40
Old returned } Long $4 \times 6\frac{1}{2}$ }.....	
} Buff. or Rdway }.....	
<i>25</i> Ft. } in. } Copper }.....	\$ 6.10
} } Galv. Iron } Pipe at.....	
} } Cast Iron }.....	
Nipples..... in. at.....	\$.....
Bushings..... to..... in. at.....	\$.....
Red'g } Couplings..... to..... in. at.....	\$.....
Inc'g }.....	
Union..... in. at.....	\$.....
Meter..... in. at.....	\$.....
Lbs. Br. Stone at.....	\$.....
Lbs. Sand at.....	\$.....
Bags Cement 'at.....	\$.....
Paving Brick } Mack } at.....	\$.....
} Red }.....	
} Asphalt }.....	
Lead Joints at.....	\$.....
Leadite Joints at.....	\$.....
<i>1</i> Hrs. Foreman at.....	\$ <i>63</i>
<i>4</i> Hrs. Common Labor at.....	\$ <i>1.63</i>
Hrs. Common Labor at.....	\$.....
Hrs. Mason at.....	\$.....
Hrs. Mason's Helper at.....	\$.....
Hrs. Compressor at.....	\$.....
Compensation Ins.....	\$ <i>06</i>
Trucking.....	\$ <i>1.00</i>
Builders' Use of Water <i>Patch</i>	\$ <i>5.00</i>
Total \$ <i>20.72</i>	

29-12 Labor and Material Report # 15

1929

14 Raymond Ave.

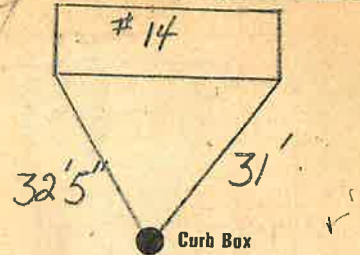

4' Main

Elev of Main at tap 4'

Gate at 25' to MAIN

Gate at

Curb Box

see above
 $3/4$ " copper
 25' to MAIN
on hole

TAX 10# 303.9-9-17