


Labor and Materials

1	Copper	} Connection	3/4	\$ 1.48
1	Lead			
1	Curb	} Cock Valve T.S.&V.	3/4 in	\$ 1.79
1	Service Box		Short 2 1/2 x 4 1/2	
	Old returned	Long 4 1/2 x 5 1/2		\$ 1.46
		Buff. or Rdway		
25	Ft. 3/4 in.	} Copper Galv. Iron Cast Iron	Pipe at	\$ 4.14
	Nipples		in. at	
	Bushings	to	in. at	\$
	Red'g Inc'g	} Couplings	to	in. at
	Union		in. at	
	Meter	in. at		\$
	Lbs. Br. Stone	at		\$
	Lbs. Sand	at		\$
	Bags Cement	at		\$
	Paving Brick	} Mack Red Asphalt	at	\$
	Lead Joints		at	
	Leadite Joints	at		\$
3	Hrs. Foreman	at		\$ 1.88
8	Hrs. Common Labor	at		\$ 3.60
	Hrs. Common Labor	at		\$
	Hrs. Mason	at		\$
	Hrs. Masons Helper	at		\$
	Hrs. Compressor	at		\$
	Compensation Ins			\$ 1.17
	Trucking			\$ 1.17
	Builders Use of Water	1/2 hr @ 1.50		\$ 2.50
Total				\$ 18.07

Labor and Material Report Oct 24 19

76 Raymond Ave

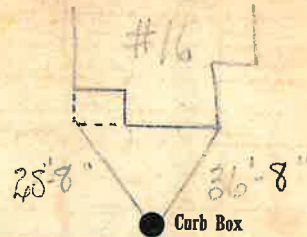

4" Main

Elev. of Main at tap 5

Gate at TAX ID # 3039-9-18 Gate at

● Curb Box

3/4" copper
25' to main

OK 2/10