


Labor and Materials

Copper } Connection.....	\$ 3.20
Lead }	
1 Curb { Cock }	\$ 1.00
{ Valve }	
{ T.S. & V. }	
1 Service Box { Short 3 1/2 x 4 1/2 }	\$ 1.30
Old returned { Long 4 1/2 x 5 1/2 }	
{ Buff. or Rdway }	
9 Ft. 3/4 in. { Copper } Pipe at.....	\$ 2.42
{ Galv. Iron }	
{ Cast Iron }	
Nipples..... in. at.....	\$
Bushings..... to..... in. at.....	\$
Red'g } Couplings..... to..... in. at.....	\$
Inc'g }	
Union..... in. at.....	\$
Meter..... in. at.....	\$
Lbs. Br. Stone at.....	\$
Lbs. Sand at.....	\$
Bags Cement at.....	\$
Paving Brick { Mack } at.....	\$
{ Red }	
{ Asphalt }	
Lead Joints at.....	\$
Leadite Joints at.....	\$
Hrs. Foreman at.....	\$
7 Hrs. Common Labor at..... 50	\$ 1.00
2 Hrs. Common Labor at..... 40 5/8	\$.81
Hrs. Mason at.....	\$
Hrs. Mason's Helper at.....	\$
Hrs. Compressor at.....	\$
Compensation Ins. at.....	\$.06
Trucking.....	\$ 1.00
Builders' Use of Water.....	\$
Total \$ 10.79	

17 Raymond Ave

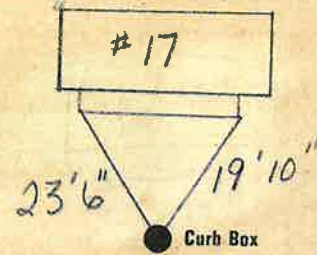

TAX ID# 303.9-10-5

Main Elev. of
Main at tap

Gate at ● ● Gate at

● Curb Box

Varnley

3/4" Copper
9' to MAIN