


LABOR AND MATERIALS

1	Copper	} Connection	3/4"	\$
1	Lead			
1	Curb	} Valve	3/4" in.	\$
1	Service box	} T.S. & V.		\$
Old returned				
		} Short 3 1/2 x 4 1/2		\$
		} Buff or Rdway		\$
25	3/4 in.	} Copper		\$
		} Pipe at		\$
	Nipples	in. at		\$
	Bushings	to in. at		\$
	Red'g	} Coupl'gs	to in. at	\$
	Inc'g			
	Union	in. at		\$
	Meter	in. at		\$
	Lead Joints	at		\$
	Compound Joints	at		\$
	Maintenance Foreman			\$
	Hrs. Water Maint. Man	1 at		\$
	Hrs. Water Maint. Man	2 at		\$
	Hrs. Garage Foreman	at		\$
	Hrs. Labor	at		\$
	Hrs. Compressor	at		\$
	Compensation Ins.	at \$ per C		\$
	Trucking			\$
	Pav't Patch			\$
				\$
				\$
	O'head			\$

Raymond Ave. No. 18

Name of Owner
McCarthy

Measured in April 30 1957
Labor and Mat'l. Report

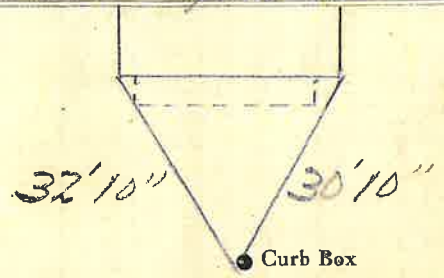

4" Main Elev. of Main at tap 4 1/2

Gate at • Gate at

TAX ID# 303.9-9-19

• Curb Box

3/4" copper
25' to MAIN