


Labor and Materials

✓	Copper } Connection	3	\$ 2.60
✓	Lead } Curb		
✓	✓	✓	
✓	Curb } Cock Valve T-S & V. }	3	\$ 2.30
✓	Service Box } Short 3 1/2 x 4 1/2 }		
✓	Old returned } Long 4 1/2 x 5 1/2 }		
✓	Buff. or Rdway }		\$ 1.40
✓	5 Ft. 3/4 in. } Copper Galv. Iron } Pipe at		\$ 1.86
✓	Cast Iron }		
✓	Nipples	in. at	\$
✓	Bushings	to in. at	\$
✓	Red'g Inc'g } Couplings	to in. at	\$
✓	Union	in. at	\$
✓	Meter	in. at	\$
✓	Lbs. Br. Stone	at	\$
✓	Lbs. Sand	at	\$
✓	Bags Cement	at	\$
✓	Paving Brick } Mack Red Asphalt }	at	\$
✓	Lead Joints	at	\$
✓	Leadite Joints	at	\$
✓	1 Hrs. Foreman	at	\$ 1.63
✓	4 Hrs. Common Labor	at	\$ 1.63
✓	Hrs. Common Labor	at	\$
✓	Hrs. Mason	at	\$
✓	Hrs. Mason's Helper	at	\$
✓	Hrs. Compressor	at	\$
✓	Compensation Ins		\$.06
✓	Trucking		\$ 1.00
✓	Builders' Use of Water	Part. etc	\$ 5.00
Total			\$ 16.48

2A=14
16/3
19 Raymond Ave.

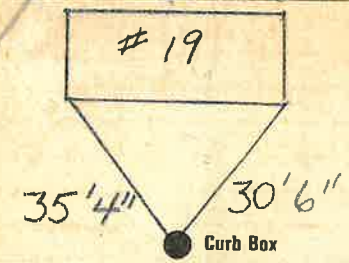

4 Main Eley of Main at tap 4'

Gate at TAX 10 # 303.9-10-4 Gate at

● Curb Box

man house
3/4" copper
5' to MAIN
over hole