

OLD Measurements

32 1/2 31 1/2

**Labor and Materials**


Copper } Connection.....	\$ 2.70
Lead } .....	
Curb } Cock Valve } .....	\$ 2.39
} T.S. & V. } .....	
Service Box } Short 3/4x1 1/2 } .....	\$ 1.45
Old returned } Long 1 1/2x5/8 } .....	
} Buff. or Rdway } .....	
5 Ft. .... in. } Copper } .....	\$ 1.89
} Galv. Iron } Pipe at.....	
} Cast Iron } .....	
Nipples..... in. at.....	\$
Bushings..... to..... in. at.....	\$
Red'g } Couplings..... to..... in. at.....	\$
Inc'g } .....	
Union..... in. at.....	\$
Meter..... in. at.....	\$
Lbs. Br. Stone at.....	\$
Lbs. Sand at.....	\$
Bags Cement at.....	\$
Paving Brick } Mack } at.....	\$
} Red } .....	
} Asphalt } .....	
Lead Joints at.....	\$
Leadite Joints at.....	\$
1 Hrs. Foreman at.....	\$ 6.3
4 Hrs. Common Labor at.....	\$ 1.80
Hrs. Common Labor at.....	\$
Hrs. Mason at.....	\$
Hrs. Mason's Helper at.....	\$
Hrs. Compressor at.....	\$
Compensation Ins.....	\$ .08
Trucking.....	\$ 1. -
Builders' Use of Water <i>Potah</i> .....	\$ 5. -
Total \$ 16.94	

**Labor and Material Report**

Sept 19

19

21 Raymond St

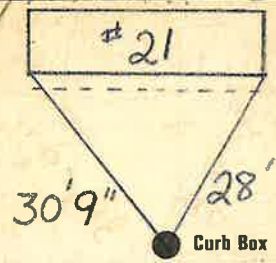

4 Main

Elev of Main at tap 4 1/2

Gate at TAX ID# 303.9-10-3 Gate at

● Curb Box

3/4" COPPER  
5' to MAIN