

LABOR AND MATERIALS


Copper	}	Connection	\$	
Lead				
Curb	}	Cock	in.	\$
		Valve		
		T. S. & V.		
Service box	}	Short $3\frac{1}{2} \times 4\frac{1}{2}$	\$	
Old returned		Long $4\frac{1}{2} \times 5\frac{1}{2}$		
		Buff or Rdway		
Ft. $\frac{3}{4}$ in.	}	Copper	Pipe at	\$
		G. I.		
		C. I.		
Nipples		in. at	\$	
Bushings		to in. at	\$	
Red'g	}	Coupl'gs	to in. at	\$
Inc'g				
Union		in. at	\$	
Meter		in. at	\$	
Lead Joints		at	\$	
Compound Joints		at	\$	
Maintenance Foreman			\$	
Hrs. Water Maint. Man-1		at	\$	
Hrs. Water Maint. Man-2		at	\$	
Hrs. Garage Foreman		at	\$	
Hrs. Labor		at	\$	
Hrs. Compressor		at	\$	
Compensation Ins. at \$		per C	\$	
Trucking			\$	
Pav't Patch			\$	
			\$	
			\$	
O'head			\$	
			\$	

St. _____
Pl. _____
Ave. No. 24

Name of Owner _____

Labor and Mat'l. Report

19

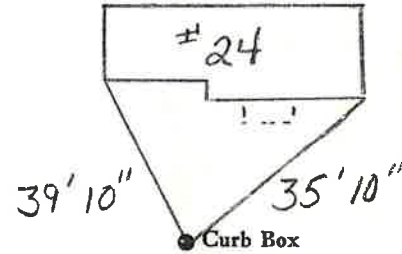

TAX ID # 303.9-9-21
4 Main Elev. of
Main at tap 4 1/2

Gate at ●

● Gate at

3/4" Copper ● Curb Box