


Labor and Materials

1	Copper	Lead	Connection.	3/4"	\$ 2.60
1	Curb	Cock Valve P.S. & V.	3/4" in.		\$ 2.27
1	Service Box	Old returned	Short 3/4" x 1/4" Long 1/2" x 5/8" Buff. or Rdway		\$ 1.38
5	Ft.	3/4" in.	Copper Galv. Iron Cast Iron	Pipe at	\$ 12.6
	Nipples		in. at		\$
	Bushings		to in. at		\$
	Red'g Inc'g	Couplings	to in. at		\$
	Union		in. at		\$
	Meter		in. at		\$
	Lbs. Br. Stone	at			\$
	Lbs. Sand	at			\$
	Bags Cement	at			\$
	Paving Brick	Mack Red Asphalt	at		\$
	Lead Joints	at			\$
	Leadite Joints	at			\$
3	Hrs. Foreman	at			\$ 1.88
16	Hrs. Common Labor	at			\$ 7.20
	Hrs. Common Labor	at			\$
	Hrs. Mason	at			\$
	Hrs. Mason's Helper	at			\$
	Hrs. Compressor	at			\$
	Compensation Ins.				\$.28
	Trucking				\$ 1.-
	Builders' Use of Water				\$
Total \$					17.87

Raymond Ave. 3/4" tap

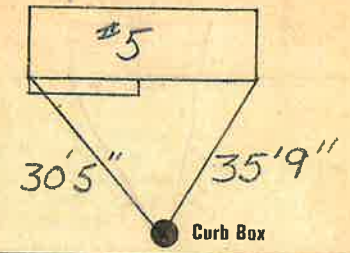

4" Main Elev of Main at tap 4.64

Gate at TAX ID # 303.9-10-11 Gate at

● Curb Box

New House

3/4" copper
5' to main