


Labor and Materials

Copper } Connection.....	3	\$ 2.60
Lead }	4	\$ 2.27
Curb } Cock Valve }	1	\$ 1.38
} T.S. & V. }	1	\$ 43.2
Service Box } Short 3/4x1/2 }		
Old returned } Long 1/2x3/4 }		
} Buff. or Rdway }		
26 Ft. in. } Copper } Pipe at.....	3/4	\$ 43.2
} Cast Iron }		
Nipples..... in. at.....		\$
Bushings..... to..... in. at.....		\$
Red'g } Couplings..... to..... in. at.....		\$
Inc'g }		\$
Union..... in. at.....		\$
Meter..... in. at.....		\$
Lbs. Br. Stone at.....		\$
Lbs. Sand at.....		\$
Bags Cement at.....		\$
Paving Brick } Mack } at.....		\$
} Red }		\$
} Asphalt }		\$
Lead Joints at.....		\$
Leadite Joints at.....		\$
2 Hrs. Foreman at.....		\$ 1.25
7 Hrs. Common Labor at.....		\$ 3.15
Hrs. Common Labor at.....		\$
Hrs. Mason at.....		\$
Hrs. Mason's Helper at.....		\$
Hrs. Compressor at.....		\$
Compensation Ins.....		\$.14
Trucking.....		\$ 1.-
Builders' Use of Water.....		\$
Total		\$ 16.11

Labor and Material Report

Apr. 20 1931

Raymond Mine

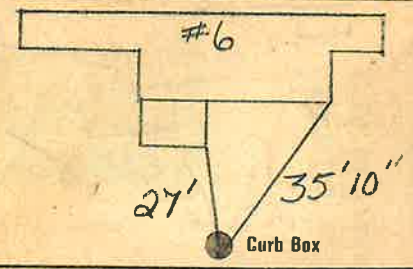

4" Main

Elev of Main at tap 5

Gate at TAX ID # 3039-9-13 Gate at

● Curb Box

New house

3/4" copper
26' to MAIN