

### Labor and Materials


Copper } Connection			\$ 2.60
Lead } Connection			
Curb } Cock	in.		\$ 2.30
Valve } T.S. & V.			
Service Box } Short 3/4x1 1/2	}		\$ 1.40
Old returned } Long 4/8x5/8			
Buff. or Rdway }			
5 Ft. } in. Copper	} Pipe at	3/4	\$ 1.86
Galv. Iron } Cast Iron			
Nipples	in. at		\$
Bushings	to in. at		\$
Red'g } Couplings	to in. at		\$
Inc'g }			
Union	in. at		\$
Meter	in. at		\$
Lbs. Br. Stone	at		\$
Lbs. Sand	at		\$
Bags Cement	'at		\$
Paving Brick } Mack	} at		\$
Red			
Asphalt }			
Lead Joints	at		\$
Leadite Joints	at		\$
2 Hrs. Foreman	at		\$ 1.25
4 Hrs. Common Labor	at		\$ 1.63
Hrs. Common Labor	at		\$
Hrs. Mason	at		\$
Hrs. Mason's Helper	at		\$
Hrs. Compressor	at		\$
Compensation Ins			\$ .08
Trucking			\$ 1.00
Builders' Use of Water	Patch		\$ 5.00

Total \$ 17.12

Labor and Material Report

4/26 1929

7 Raymond Ave.

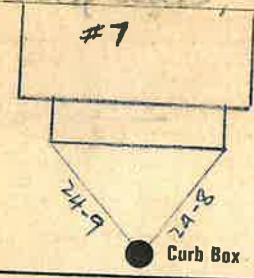


4" Main

Elev of Main at tap 4 1/2

Gate at TAX ID # 303.9-10-10 Gate at

Curb Box

3/4" COPPER  
5' TO MAIN

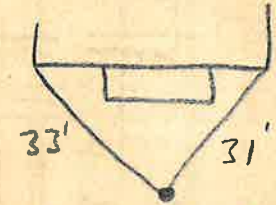

OUTSIDE CLEANOUT