

Labor and Materials


1	Copper } Connection	1/2	\$ 3.20	
	Lead } Connection	1/2		
1	Curb } Cock Valve	2	\$ 1.00	
	T.S. & V. }	1/2		
1	Service Box } Short 3 1/2 x 4 1/2		\$ 1.30	
	Old returned } Long 4 x 5			
		Buff. or Rdway		
30	Ft. in. } Copper		\$ 6.16	
		Galv. Iron } Pipe at		
		Cast Iron }		
	Nipples	in. at	\$	
	Bushings	to in. at	\$	
	Red'g } Couplings	to in. at	\$	
	Inc'g }			
	Union	in. at	\$	
	Meter	in. at	\$	
	Lbs. Br. Stone	at	\$	
	Lbs. Sand	at	\$	
	Bags Cement	at	\$	
	Paving Brick } Mack	} at	\$	
				Red
				Asphalt
	Lead Joints	at	\$	
	Leadite Joints	at	\$	
1	Hrs. Foreman	at 6.25	\$ 6.3	
2	Hrs. Common Labor	at 5.0	\$ 10.0	
14	Hrs. Common Labor	at 4.0 3/8	\$ 56.8	
	Hrs. Mason	at	\$	
	Hrs. Mason's Helper	at	\$	
	Hrs. Compressor	at	\$	
	Compensation Ins.		\$ 2.0	
	Trucking		\$ 1.00	
	Builders' Use of Water		\$	
Total			\$ 201.7	

26-150

Labor and Material Report

Sept 5 1926

8 Raymond Ave

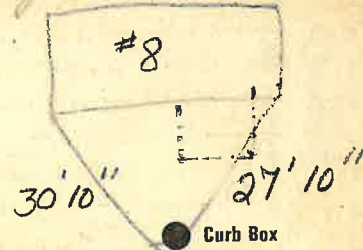

4" Main

Elev. of Main at tap 4 1/2

Gate at

TAX 10 # 303.9-9-14

Gate at

● Curb Box

3/4" COPPER
30' to MAIN

Labor and Materials

1	Copper	Connection	3		\$ 3.20	
	Lead					
1	Curb	{ Cock Valve T. S. & V. }	3/4	in.	\$ 1.00	
1	Service Box	{ Short 3 1/2 x 4 1/2 }			\$ 1.30	
	Old returned	{ Long 4 1/2 x 5 1/2 }				
		{ Buff. or Rdway }				
25	Ft.	{ Copper Galv. Iron Cast Iron }		in. Pipe at.	\$ 50.6	
	Nipples			in. at.	\$	
	Bushings		to	in. at.	\$	
1	Red g. Inc's	Couplings	1/4	to	in. at.	\$ 1.50
	Union			in. at.	\$	
	Meter			in. at.	\$	
	Lbs. Br. Stone	at			\$	
	Lbs. Sand	at			\$	
	Bags Cement	at			\$	
	Paving Brick	{ Mack Red Asphalt }		at	\$	
	Lead Joints	at			\$	
	Leadite Joints	at			\$	
2	Hrs. Foreman	at	6 2 1/2		\$ 1.25	
3	Hrs. Common Labor	at	50		\$ 1.50	
	Hrs. Common Labor	at			\$	
	Hrs. Mason	at			\$	
	Hrs. Mason's Helper	at			\$	
	Hrs. Compressor	at			\$	
	Compensation Ins.				\$.07	
	Trucking				\$ 1.00	
	Builders' Use of Water				\$	
Total					\$ 14.53	

Labor and Material Report *Sept 31* 1927

no 8 Raymond Ave.
no measurement

● Curb Box

4 Main

Elev. of Main at tap *5'*

Gate at ●

● Gate at

● Curb Box

new tap
adjacent lot.