

**Labor and Materials**


1	Copper	Connection	.....	\$ 2.70
1	Curb	Cock Valve T. S. & V.	..... in. 3	\$ 2.39
1	Service Box	Short 3/4x4 1/2 Long 4x5 1/2 Buff. or Rdway	.....	\$ 1.45
5	Pt.	Copper Galv. Iron Cast Iron	..... in. at 3	\$ 1.89
	Nipples	.....	in. at	\$
	Bushings	.....	to..... in. at	\$
	Red'g Inc'g	Couplings	..... to..... in. at	\$
	Union	.....	in. at	\$
	Meter	.....	in. at	\$
	Lbs. Br. Stone	at	.....	\$
	Lbs. Sand	at	.....	\$
	Bags Cement	at	.....	\$
	Paving Brick	Mack Red Asphalt	..... at	\$
	Lead Joints	at	.....	\$
	Leadite Joints	at	.....	\$
3	Hrs. Foreman	at	.....	\$ 1.85
8	Hrs. Common Labor	at	.....	\$ 3.60
	Hrs. Common Labor	at	.....	\$
	Hrs. Mason	at	.....	\$
	Hrs. Mason's Helper	at	.....	\$
	Hrs. Compressor	at	.....	\$
	Compensation Ins	.....	.....	\$ 1.7
	Trucking	.....	.....	\$ 1.00
	Builders' Use of Water	Patch	.....	\$ 5.-
	Total \$			20.08

30-27

Labor and Material Report

Apr 23 1930

9 Raymond Ave

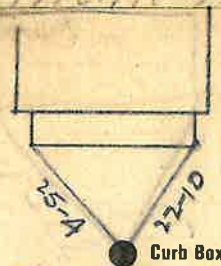

Curb Box

4 Main

Elev of Main at tap

Gate at TAX ID # 303.9-10-9

Gate at

Curb Box

New House  
3/4" copper  
5' to main