


Labor and Materials

1	Copper	Connection	\$	
	Lead				
1	Curb	Cock Valve in.	\$	
		T.S. & V.			
1	Service Box	Short 3 1/2 x 4 1/2	}	\$	
	Old returned	Long 4 1/2 x 5 1/2			
		Buff. or Rdway			
25	Ft.	Copper	} Pipe at 3/4"	\$	
	in.	Galv. Iron			
		Cast Iron			
	Nipples	in. at	\$	
	Bushings	to in. at	\$	
	Red'g Inc'g	Couplings	to in. at	\$
	Union	in. at	\$	
	Meter	in. at	\$	
	Lbs. Br. Stone	at	\$	
	Lbs. Sand	at	\$	
	Bags Cement	at	\$	
	Paving Brick	} Mack Red Asphalt	} at	\$	
	Lead Joints	at	\$	
	Leadite Joints	at	\$	
	Hrs. Foreman	at	\$	
	Hrs. Common Labor	at	\$	
	Hrs. Common Labor	at	\$	
	Hrs. Mason	at	\$	
	Hrs. Mason's Helper	at	\$	
	Hrs. Compressor	at	\$	
	Compensation Ins.		\$	
	Trucking		\$	
	Builders' Use of Water		\$	
Total \$				

29-118? *Watermain*
Labor and Material Report 2-5-1930

10 Raymond Ave.

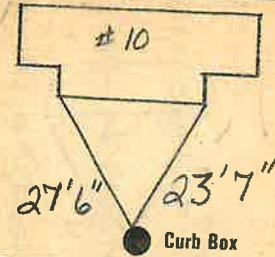

4 Main

Elev of Main at tap 4

Gate at TAX # 10 # 303.9 9-15 Gate at

● Curb Box

House measurement

*3/4" copper
 25' to main*