


Labor and Materials

Copper } Connection.....	\$
Lead }	\$
Curb } Cock Valve } 3/4 in.	\$
} T. S. & V. }	\$
Service Box } Short 3 1/2 x 4 1/2 }	\$
Old returned } Long 4 1/2 x 5 1/2 }	\$
} Buff. or Rdway }	\$
27 Ft. 3/4 in. } Copper } Pipe at.....	\$
} Galv. Iron }	\$
} Cast Iron }	\$
Nipples..... in. at.....	\$
Bushings..... to..... in. at.....	\$
1 Red'g } Couplings..... to..... in. at.....	\$
Inc'g }	\$
Union..... in. at.....	\$
Meter..... in. at.....	\$
Lbs Br. Stone at.....	\$
Lbs. Sand at.....	\$
Bags Cement at.....	\$
Paving Brick } Mack } at.....	\$
} Red }	\$
} Asphalt }	\$
Lead Joints at.....	\$
Leadite Joints at.....	\$
Hrs. Foreman at.....	\$
3 Hrs. Common Labor at..... <i>Dull 50</i>	\$ 1.50
5 Hrs. Common Labor at..... <i>40 5/8</i>	\$ 2.07
Hrs. Mason at.....	\$
Hrs. Mason's Helper at.....	\$
Hrs. Compressor at.....	\$
Compensation Ins.....	\$
Trucking.....	\$
Builders' Use of Water.....	\$
Total \$	<u>3.57</u>

Labor and Material Report

1920

15 Raymond Ave

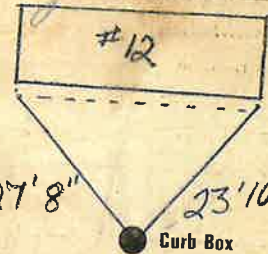

Curb Box

Main

Elev. of Main at tap

Gate at

TAX ID # 303.9-9-10

Gate at

Curb Box

3/4" copper
27' to main