

LABOR AND MATERIALS

1	Copper Lead	Connection	3/4"	\$	3.08
1	Curb	Cock Valve T.S. & V.	3/4 in.	\$	3.99
1	Service box	Short 3 1/2 x 4 1/2			
	Old returned	Long 4 1/2 x 5 1/2			
		Buff or Rdway		\$	4.32
27	Ft.	Copper G.I. Pipe at	3/4 in. 45	\$	12.15
	Nipples	in. at		\$	
	Bushings	to in. at		\$	
	Red'g Inc'g	Coupl'gs to in. at		\$	
	Union	in. at		\$	
	Meter	in. at		\$	
	Lead Joints	at		\$	
	Compound Joints	at		\$	
	Maintenance Foreman			\$	
	Hrs. Water Maint. Man-1	at		\$	
	Hrs. Water Maint. Man-2	at		\$	
3	Hrs. Garage Foreman	at	2.033	\$	6.10
3	Hrs. Labor	at	1.30	\$	3.90
	Hrs. Compressor	at		\$	
	Compensation Ins.	at \$ 5.686 per C		\$	.06
	Trucking			\$	1.50
	Pay't Patch			\$	
	Tap by Wad Teigh & Bureau 11-9-56			\$	
	O'head			\$	
				\$	35.00

Lot-8


St. Dr.  
Pl. #1  
Ave. No. 1

Reservoir

Name of Owner

Durling

Labor and Mat'l. Report Nov. 9 19 56

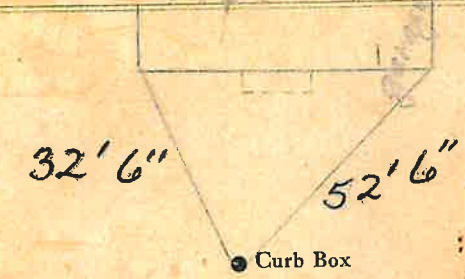

Transite  
6" Main

Elev. of Main at tap 4'

Gate at • Gate at

TAX ID # 302.13-1-31

• Curb Box

Water Main in  
the Middle of the Road