

LABOR AND MATERIALS

1	Copper	} Connection	3/4"	\$
1	Lead			\$
1	Curb	} Cock Valve T. S. & V.	3/4 in.	\$
1	Service box			\$
	Old returned	} Short 3 1/2 x 4 1/2 Long 4 1/2 x 5 1/2 Buff or Rdway		\$
24	Ft. 3/4 in.		} Copper G.I. G.I.	} Pipe at
	Nipples	in. at		
	Bushings	to in. at	\$	
	Red'g Inc'g	} Coupl'gs	to in. at	\$
	Union		in. at	\$
	Meter	in. at	\$	
	Lead Joints	at	\$	
	Compound Joints	at	\$	
	Maintenance Foreman		\$	
	Hrs. Water Maint. Man-1	at	\$	
	Hrs. Water Maint. Man-2	at	\$	
	Hrs. Garage Foreman	at	\$	
	Hrs. Labor	at	\$	
	Hrs. Compressor	at	\$	
	Compensation Ins.	at \$ per C	\$	
	Trucking		\$	
	Pav't Patch		\$	
	Tap by Record		\$	
	Peter 5017	4-8-57	\$	
	O'head		\$	


Lot. - #30

St. Dr.
Pl.
Ave. No. 12

Reservoir

Name of Owner
Coloney Homes

Labor and Mat'l. Report April 8 1957

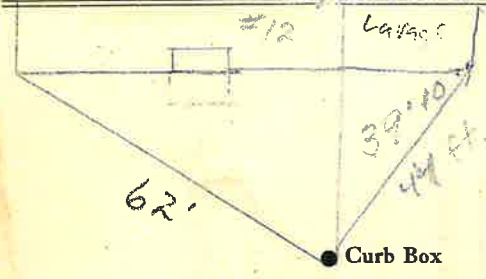

Transite
6" Main Elev. of Main at tap 5'

Gate at • Gate at
TAX ID# 302.17-4-13

• Curb Box