

LABOR AND MATERIALS

1 Copper } Connection $3/4"$ \$
 1 Lead }
 1 Curb } Cock } $3/4$ in. \$
 1 } Valve }
 1 } T.S. & V. }
 1 Service box } Short $3\frac{1}{2} \times 4\frac{1}{2}$ }
 Old returned } Long $4\frac{1}{2} \times 5\frac{1}{2}$ }
 } Buff or Rdway } \$
 27 Ft. $3/4$ in. } Copper } Pipe at \$
 } G.I. }
 } C.I. }
 Nipples in. at \$
 Bushings to in. at \$
 Red'g } Coupl'gs to in. at \$
 Inc'g }
 Union in. at \$
 Meter in. at \$
 Lead Joints at \$
 Compound Joints at \$
 Maintenance Foreman \$
 Hrs. Water Maint. Man-1 at \$
 Hrs. Water Maint. Man-2 at \$
 Hrs. Garage Foreman at \$
 Hrs. Labor at \$
 Hrs. Compressor at \$
 Compensation Ins. at \$ per C \$
 Trucking \$
 Pav't Patch \$
 Tap by Gifford & Co. \$
 6/14/57 \$
 O'head \$
 \$

Lot. #31 ✓

St. Dr.
 -Pl:
 Ave. No. 14


Reservoir

Name of Owner

Kurzmack

Labor and Mat'l. Report

June 14 1957

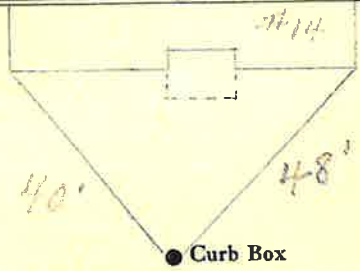

Transite

6" Main

Elev. of 5'
 Main at tap

Gate at • Gate at

TAX ID # 302.17-4-14

• Curb Box

Water
 Main in middle of the Road